

LONDON, OH. STREET AND WATERLINE IMPROVEMENT PLAN

MAY, 1989

KENY BOULEVARD

1989 SPECIFICATIONS

THE STANDARD SPECIFICATIONS OF THE STATE OF OHIO,
DEPARTMENT OF TRANSPORTATION, INCLUDING CHANGES
AND SUPPLEMENTAL SPECIFICATIONS LISTED IN THE
PROPOSAL SHALL GOVERN THIS IMPROVEMENT.

WE HEREBY ACCEPT AND APPROVE THESE PLANS:


APPROVED David S. Cole 2-2-97
MAYOR OF LONDON
DATE

APPROVED David Eades 8-9-97
BOARD OF PUBLIC UTILITIES
DATE


APPROVED Bill Gill, Chairperson 2-10-97
CHAIRPERSON, LONDON CITY DATE
PLANNING COMMISSION, WILLIAM ROBISON

APPROVED Elmer Olsen 2-17-97
CITY OF LONDON SAFETY -
SERVICE DIRECTOR
DATE

CALL BEFORE YOU DIG
2 WORKING DAYS NOTICE
800 362 2764
OHIO UTILITIES PROTECTION SERVICE
NON MEMBERS MUST BE CALLED DIRECTLY

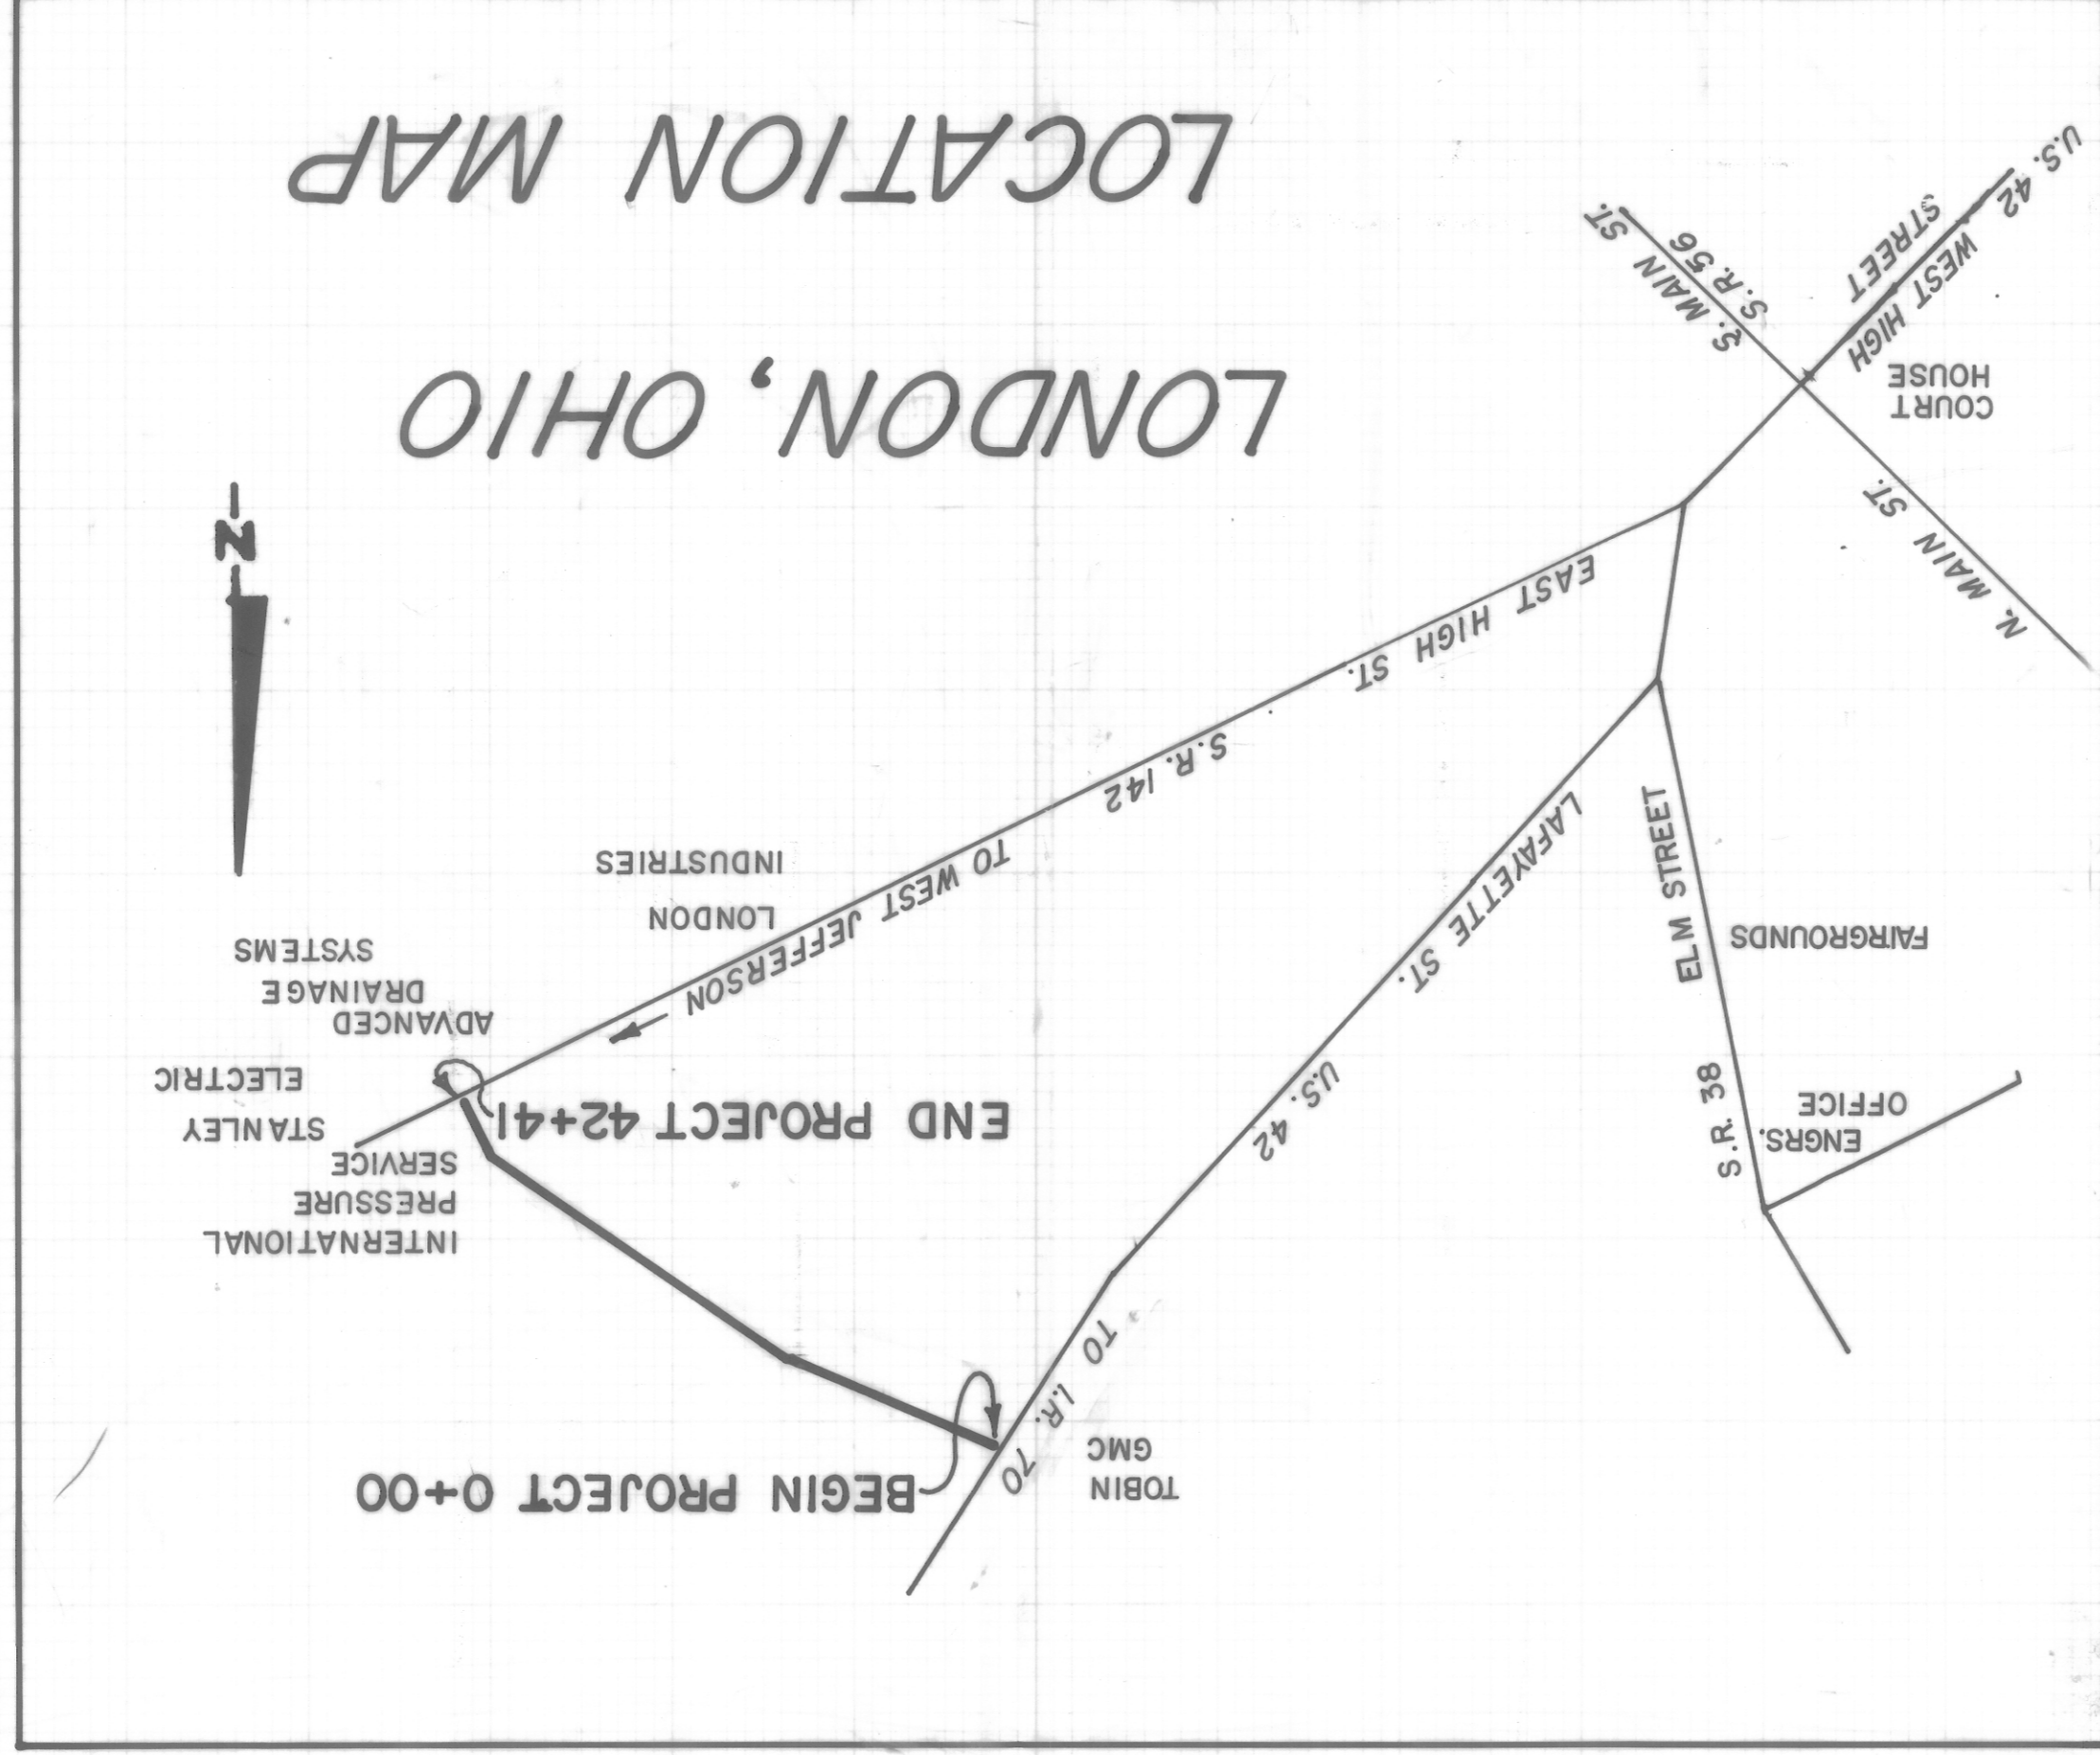

TYPICAL CROSS-SECTION

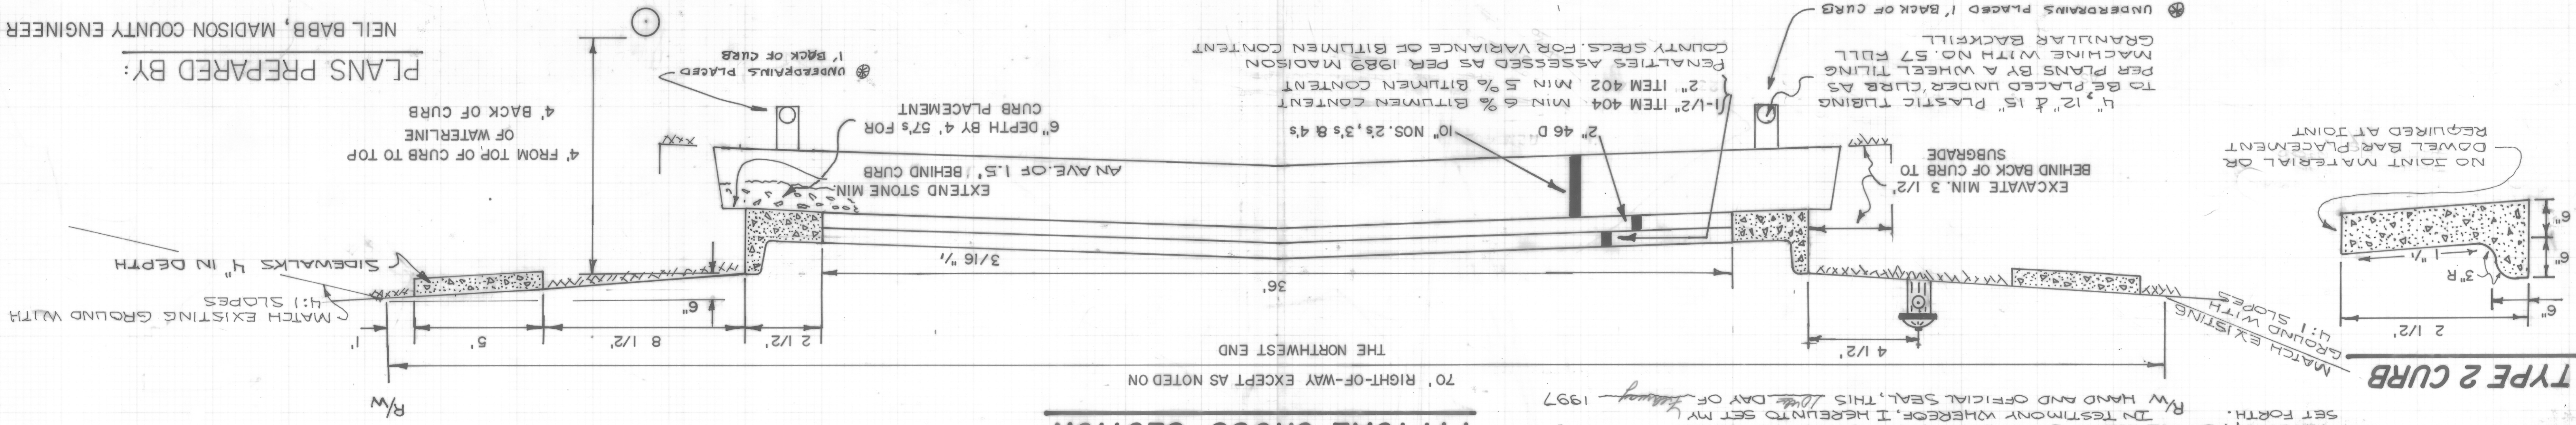

PLANS PREPARED BY:
NEIL C. GABB, MADISON COUNTY ENGINEER

THE ATTACHED SHEETS 2, 3, AND 4, HAVE BEEN UP-DATED
TO REPRESENT PROPERTY TRANSFERS AND EASEMENTS FOR
KENY BOULEVARD AS 2/1/97. THE ATTACHED PLANS SHOW THE
"AS BUILT" CONSTRUCTION FOR THE BOULEVARD
NEIL C. GABB DATE
AS MADISON COUNTY
ENGINEER

WE, THE UNDERSIGNED PROPERTY OWNERS, HEREBY
GRANT AND DEDICATE FOR PUBLIC HIGHWAY USE AND
PUBLIC UTILITY PURPOSES, ALL OF OUR INTEREST IN ANY
REAL PROPERTY LOCATED WITHIN THE PLATTED RIGHT-OF-WAY
LINES (AS SHOWN BY DASHED LINES) ON THE ATTACHED PAGES
AS DESIGNATED AND NUMBERED BY 2/7, 3/7 AND 4/7 FOR
THE KENY BOULEVARD, LONDON, OHIO.

Julianne Keny 2/10/97 Julianne Keny 2/10/97
GEGHARD KENY DATE JULIANNE KENY DATE

John M. Reade 2-10-97 John M. Reade 2-10-97
NECCO AMERICA CORP JOHN M. READE, PRES. DATE

Karen C. Peters 2-10-97 Karen C. Peters 2-10-97
LONDON COMMUNITY FOUNDATION
KAREN C. PETERS, PRES. DATE

John J. Bland 2/7/97 John J. Bland 2/7/97
JOHN J. BLAND, INC., JOHN J. BLAND PRES. DATE

SIGNED AND ACKNOWLEDGED IN PRESENCE OF:
WITNESS
STATE OF OHIO
MADISON COUNTY

BEFORE ME, A NOTARY PUBLIC IN AND FOR SAID COUNTY AND STATE,
PERSONALLY APPEARED THE ABOVE NAMED, WHO ACKNOWLEDGED
THAT THEY DID SIGN ABOVE, AND THAT THE SAME IS THEIR FREE ACT
AND DEED, FOR THE USES AND PURPOSES ABOVE STATED AND HEREON
IN TESTIMONY WHEREOF, I HEREBY SET MY
HAND AND OFFICIAL SEAL, THIS 10th DAY OF February 1997

COMPLETION DATE 1 JULY 1990

ALL CONSTRUCTION STAKING WILL BE
COMPLETED BY THE MADISON COUNTY ENGINEER
INSPECTION WILL BE COMPLETED BY THE
MADISON COUNTY ENGINEER

SUPPLEMENTAL CONDITIONS

DRAWING NUMBER

DRAWING NUMBER

1