



FACILITY IDENTIFICATION			
050	OPERATIONS BUILDING	555	FUTURE INDUSTRIAL WATER REUSE FACILITY
150	SEPTAGE RECEIVING	580	EFFLUENT PUMP STATION, INCLUDING: 530 EFFLUENT WATER REUSE PUMP STATION 531 SODIUM HYPOCHLORITE FEED
200	HEADWORKS FACILITY	580.f	FUTURE EFFLUENT PUMP STATION
250	FUTURE ODOR CONTROL	610	THICKENING FACILITY, INCLUDING 450 RAS PUMP STATION 610 WAS PUMP STATION
310	FUTURE PRIMARY CLARIFIERS SPLITTER BOX	610.f	FUTURE THICKENING FACILITY
320	FUTURE PRIMARY CLARIFIERS	620	DIGESTION FACILITY, INCLUDING: 630 SLUDGE STORAGE TANK 640 FUTURE WATER SLUDGE TANK
410	BIOREACTORS SPLITTER BOX	650	DEWATERING FACILITY
420	BIOREACTORS	660	CAKE STORAGE AND HANDLING FACILITY
420.f	FUTURE BIOREACTORS	700	PLANT DRAIN PUMP STATION
430	SECONDARY CLARIFIERS SPLITTER BOX	900	ELECTRIC BUILDING NO. 1
440	SECONDARY CLARIFIERS	910	GENERATOR NO. 1
440.f	FUTURE SECONDARY CLARIFIERS		
460	ALUM STORAGE AND FEED SYSTEM		
510	FUTURE TERTIARY FILTERS & INLET CHAMBER		
520	UV DISINFECTION FACILITY, INCLUDING: 560 POST-AERATION TANKS 561 POST-AERATION BLOWERS		

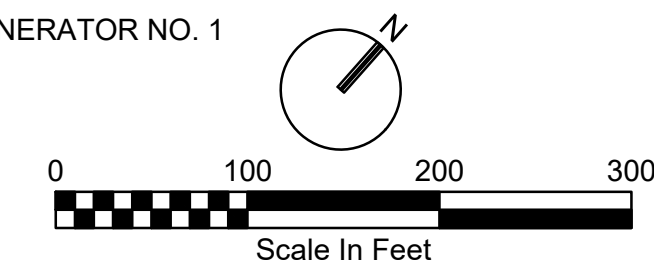

NOTES

- SEE DWG 005-C-100 FOR THE MASTER PLAN FOR THE DEER CREEK WRF AND COLLECTION SYSTEM. SEE DWG 005-Y-100 FOR THE OVERALL WRF YARD PIPING PLAN. SEE DWG 005-E-101 FOR THE OVERALL WRF ELECTRIC SITE PLAN.
- SEE DWG 005-C-150 FOR THE EARLY SITE PACKAGE OVERALL PLAN. THE EARLY SITE PACKAGE PLAN INSTALLED THE ROUGH GRADING, STORMWATER SYSTEM, EROSION CONTROL, ENTRANCE ROAD, PRIMARY ELECTRIC FEED, AND PARTIAL INFRASTRUCTURE AND YARD PIPING FOR THE WRF.
- A PERIMETER DIVERSION SWALE IS ALONG THE WEST AND SOUTH BOUNDARIES OF THE SITE. THE DIVERSION SWALE WILL COLLECT OFFSITE RUNOFF AND ROUTE IT TO THE EXISTING ONSITE POND, WHICH IS SIMILAR TO EXISTING CONDITIONS.
- THE PROPOSED WET STORMWATER POND WILL COLLECT AND TREAT ONSITE RUNOFF. THE PROPOSED WET POND WILL DISCHARGE TO THE EXISTING ONSITE POND, SIMILAR TO EXISTING CONDITIONS. THE EXISTING ONSITE POND CURRENTLY DISCHARGES INTO A DRAINAGE DITCH AT THE SOUTHEAST CORNER OF THE SITE THAT DISCHARGES INTO A CULVERT UNDER I-70. THE STORMWATER SYSTEM WILL MAINTAIN EXISTING DRAINAGE PATTERNS AND DISCHARGE AT A RATE LESS THAN PRE-DEVELOPMENT CONDITIONS.

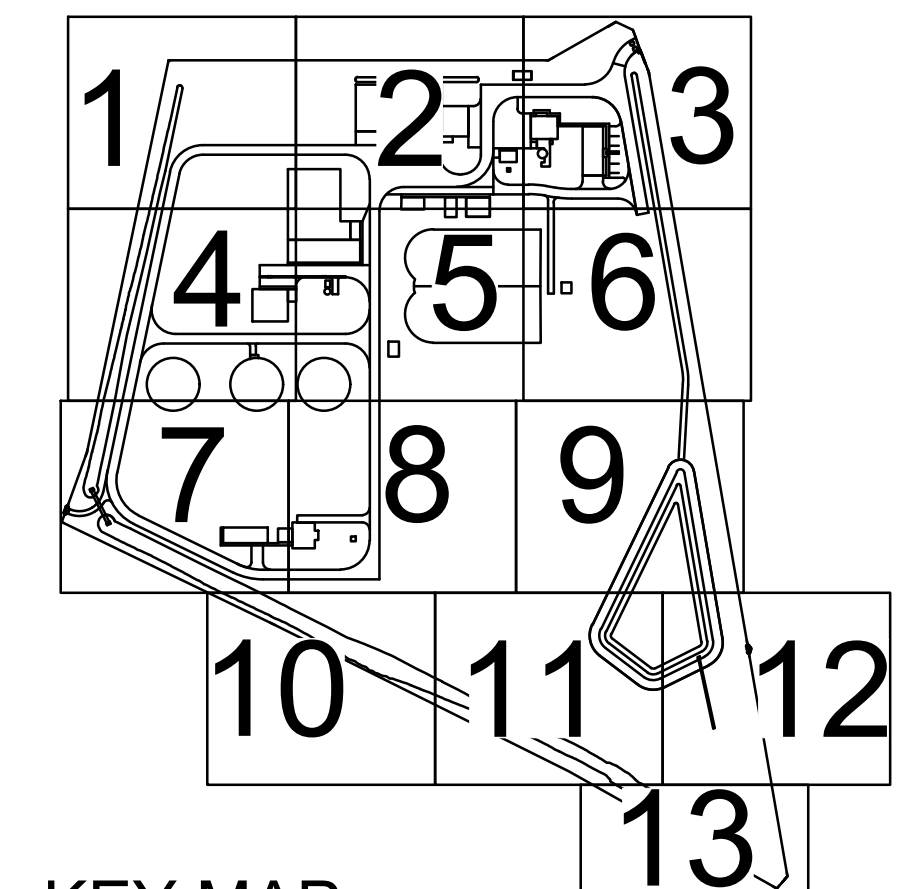


KEY MAP

**MID-OHIO DEER CREEK WRF (CMAR)
FINAL TOPSOIL AND SEEDING TO INCLUDE IN EARLY SITE PREP. BID PACKAGE**

See enlarged sheets starting with 005-C-151. Final topsoil and seeding to be included is highlighted in yellow. Silt fence to be added shown in green.

DEER CREEK WRF Mid-Ohio Water and Sewer District London - OH		NO.		DATE		DR		CHK		APVD	
		T. MALONE		T. MALONE		P. MADEJ		J. RAMOS		T. MALONE	
 CIVIL OVERALL WRF SITE PLAN		1" = 100'		VERIFY SCALE		DATE		PROJ		DWG	
		BAR IS ONE INCH ON ORIGINAL DRAWING.		2025/08/01		C6A24900		005-C-101		PTI DOCUMENT	

REUSE OF DOCUMENTS: THIS DOCUMENT AND THE IDEAS AND DESIGNS INCORPORATED HEREIN, AS AN INSTRUMENT OF PROFESSIONAL SERVICE, IS THE PROPERTY OF JACOBS AND IS NOT TO BE USED, IN WHOLE OR IN PART, FOR ANY OTHER PROJECT WITHOUT THE WRITTEN AUTHORIZATION OF JACOBS. © JACOBS 2018. ALL RIGHTS RESERVED.


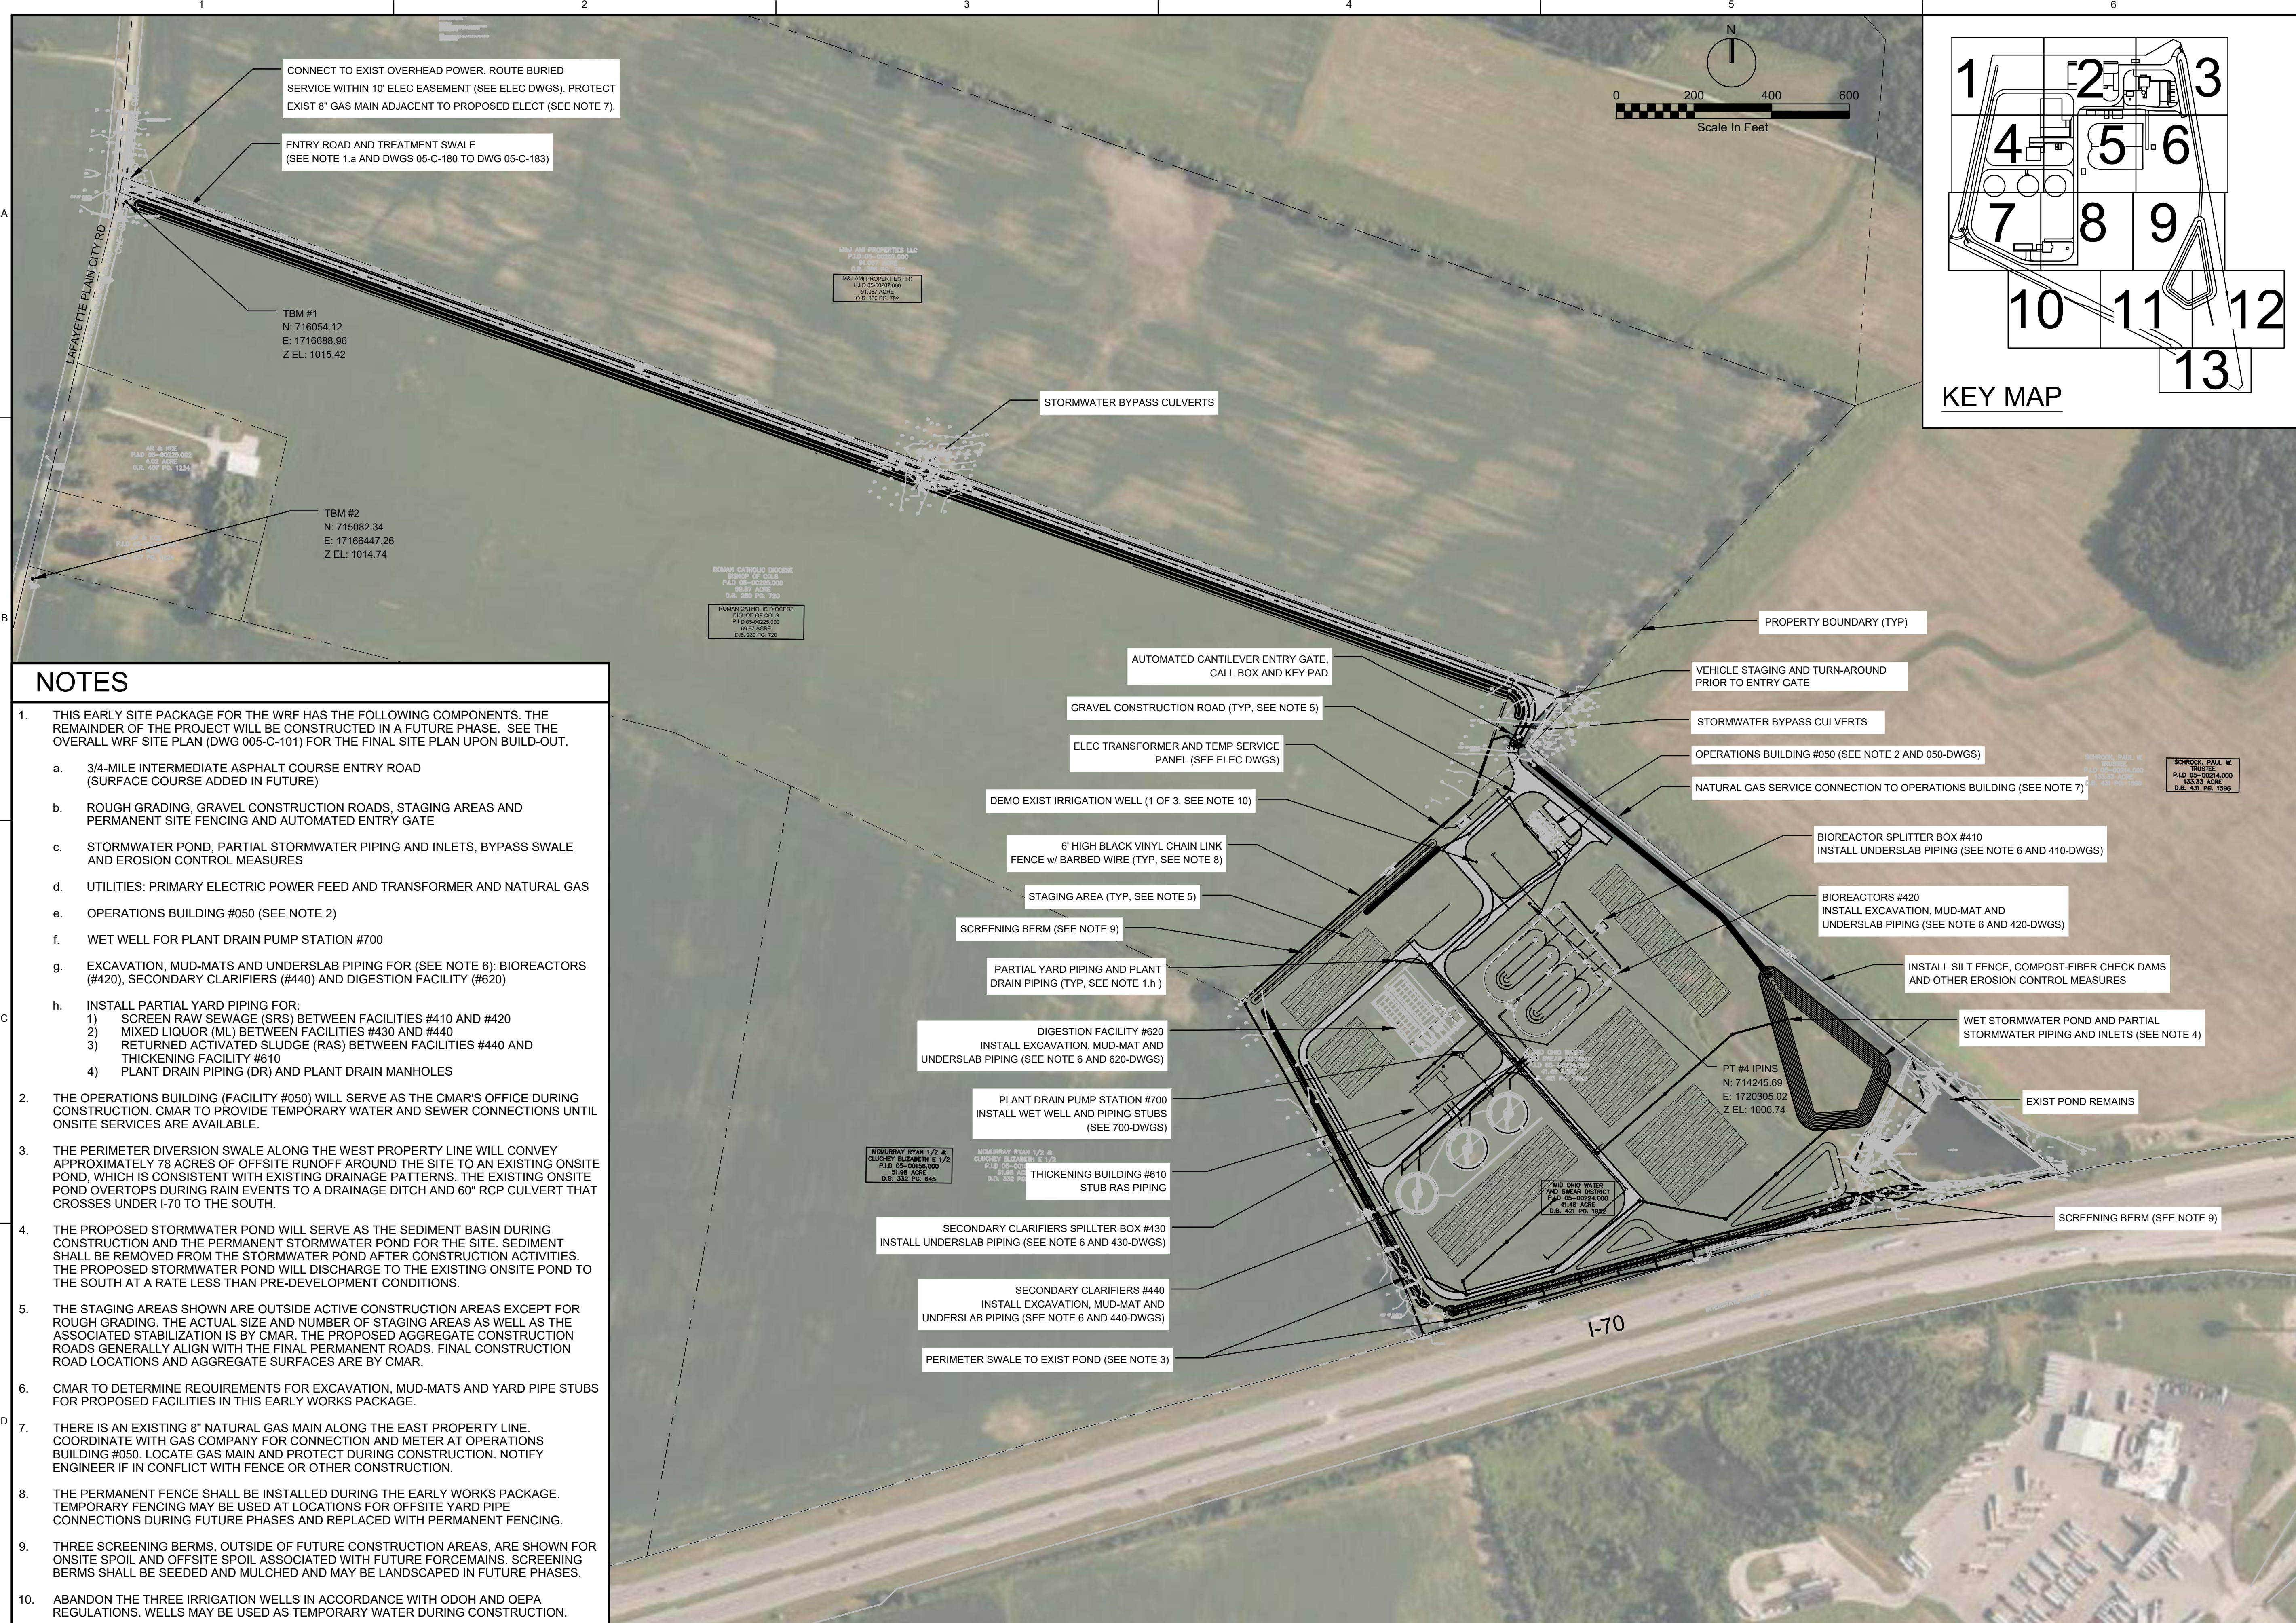


CONNECT TO EXIST OVERHEAD POWER, ROUTE BURIED SERVICE WITHIN 10' ELEC EASEMENT (SEE ELEC DWGS). PROTECT EXIST 8" GAS MAIN ADJACENT TO PROPOSED ELEC (SEE NOTE 7).

ENTRY ROAD AND TREATMENT SWALE (SEE NOTE 1.a AND DWGS 05-C-180 TO DWG 05-C-183)

TBM #1
N: 716054.12
E: 1716688.96
Z EL: 1015.42

TBM #2
N: 715082.34
E: 17166447.26
Z EL: 1014.74

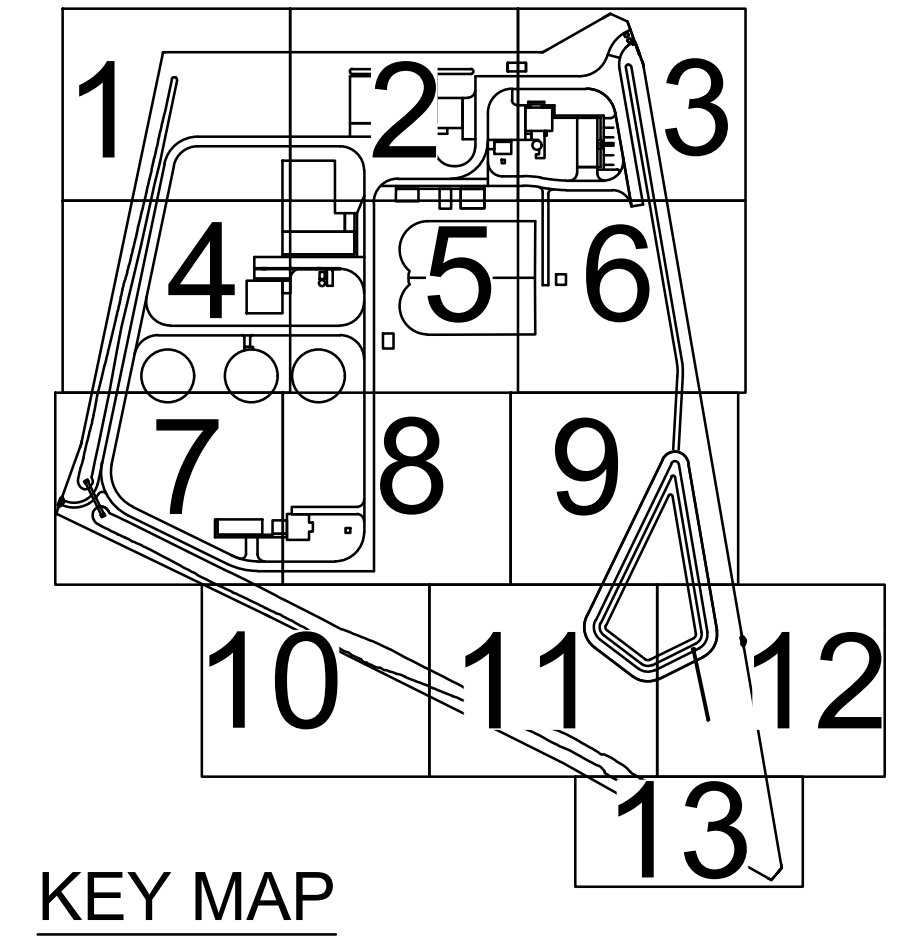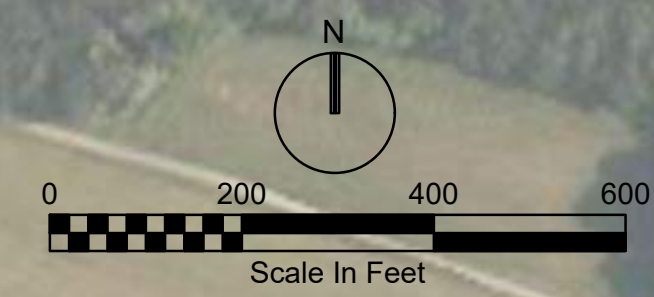

NOTES

- THIS EARLY SITE PACKAGE FOR THE WRF HAS THE FOLLOWING COMPONENTS. THE REMAINDER OF THE PROJECT WILL BE CONSTRUCTED IN A FUTURE PHASE. SEE THE OVERALL WRF SITE PLAN (DWG 005-C-101) FOR THE FINAL SITE PLAN UPON BUILD-OUT.
 - 3/4-MILE INTERMEDIATE ASPHALT COURSE ENTRY ROAD (SURFACE COURSE ADDED IN FUTURE)
 - ROUGH GRADING, GRAVEL CONSTRUCTION ROADS, STAGING AREAS AND PERMANENT SITE FENCING AND AUTOMATED ENTRY GATE
 - STORMWATER POND, PARTIAL STORMWATER PIPING AND INLETS, BYPASS SWALE AND EROSION CONTROL MEASURES
 - UTILITIES: PRIMARY ELECTRIC POWER FEED AND TRANSFORMER AND NATURAL GAS
 - OPERATIONS BUILDING #050 (SEE NOTE 2)
 - WET WELL FOR PLANT DRAIN PUMP STATION #700
 - EXCAVATION, MUD-MATS AND UNDERSLAB PIPING FOR (SEE NOTE 6): BIOREACTORS (#420), SECONDARY CLARIFIERS (#440) AND DIGESTION FACILITY (#620)
 - INSTALL PARTIAL YARD PIPING FOR:
 - SCREEN RAW SEWAGE (SRS) BETWEEN FACILITIES #410 AND #420
 - MIXED LIQUOR (ML) BETWEEN FACILITIES #430 AND #440
 - RETURNED ACTIVATED SLUDGE (RAS) BETWEEN FACILITIES #440 AND THICKENING FACILITY #610
 - PLANT DRAIN PIPING (DR) AND PLANT DRAIN MANHOLES
- THE OPERATIONS BUILDING (FACILITY #050) WILL SERVE AS THE CMAR'S OFFICE DURING CONSTRUCTION. CMAR TO PROVIDE TEMPORARY WATER AND SEWER CONNECTIONS UNTIL ONSITE SERVICES ARE AVAILABLE.
- THE PERIMETER DIVERSION SWALE ALONG THE WEST PROPERTY LINE WILL CONVEY APPROXIMATELY 78 ACRES OF OFFSITE RUNOFF AROUND THE SITE TO AN EXISTING ONSITE POND, WHICH IS CONSISTENT WITH EXISTING DRAINAGE PATTERNS. THE EXISTING ONSITE POND OVERTOPS DURING RAIN EVENTS TO A DRAINAGE DITCH AND 60" RCP CULVERT THAT CROSSES UNDER I-70 TO THE SOUTH.
- THE PROPOSED STORMWATER POND WILL SERVE AS THE SEDIMENT BASIN DURING CONSTRUCTION AND THE PERMANENT STORMWATER POND FOR THE SITE. SEDIMENT SHALL BE REMOVED FROM THE STORMWATER POND AFTER CONSTRUCTION ACTIVITIES. THE PROPOSED STORMWATER POND WILL DISCHARGE TO THE EXISTING ONSITE POND TO THE SOUTH AT A RATE LESS THAN PRE-DEVELOPMENT CONDITIONS.
- THE STAGING AREAS SHOWN ARE OUTSIDE ACTIVE CONSTRUCTION AREAS EXCEPT FOR ROUGH GRADING. THE ACTUAL SIZE AND NUMBER OF STAGING AREAS AS WELL AS THE ASSOCIATED STABILIZATION IS BY CMAR. THE PROPOSED AGGREGATE CONSTRUCTION ROADS GENERALLY ALIGN WITH THE FINAL PERMANENT ROADS. FINAL CONSTRUCTION ROAD LOCATIONS AND AGGREGATE SURFACES ARE BY CMAR.
- CMAR TO DETERMINE REQUIREMENTS FOR EXCAVATION, MUD-MATS AND YARD PIPE STUBS FOR PROPOSED FACILITIES IN THIS EARLY WORKS PACKAGE.
- THERE IS AN EXISTING 8" NATURAL GAS MAIN ALONG THE EAST PROPERTY LINE. COORDINATE WITH GAS COMPANY FOR CONNECTION AND METER AT OPERATIONS BUILDING #050. LOCATE GAS MAIN AND PROTECT DURING CONSTRUCTION. NOTIFY ENGINEER IF IN CONFLICT WITH FENCE OR OTHER CONSTRUCTION.
- THE PERMANENT FENCE SHALL BE INSTALLED DURING THE EARLY WORKS PACKAGE. TEMPORARY FENCING MAY BE USED AT LOCATIONS FOR OFFSITE YARD PIPE CONNECTIONS DURING FUTURE PHASES AND REPLACED WITH PERMANENT FENCING.
- THREE SCREENING BERMS, OUTSIDE OF FUTURE CONSTRUCTION AREAS, ARE SHOWN FOR ONSITE SPOIL AND OFFSITE SPOIL ASSOCIATED WITH FUTURE FORCEMAINS. SCREENING BERMS SHALL BE SEEDED AND MULCHED AND MAY BE LANDSCAPED IN FUTURE PHASES.
- ABANDON THE THREE IRRIGATION WELLS IN ACCORDANCE WITH ODOH AND OEPA REGULATIONS. WELLS MAY BE USED AS TEMPORARY WATER DURING CONSTRUCTION.

STORMWATER BYPASS CULVERTS

AUTOMATED CANTILEVER ENTRY GATE, CALL BOX AND KEY PAD

GRAVEL CONSTRUCTION ROAD (TYP. SEE NOTE 5)

ELEC TRANSFORMER AND TEMP SERVICE PANEL (SEE ELEC DWGS)

DEMO EXIST IRRIGATION WELL (1 OF 3, SEE NOTE 10)

6' HIGH BLACK VINYL CHAIN LINK FENCE w/ BARBED WIRE (TYP. SEE NOTE 8)

STAGING AREA (TYP. SEE NOTE 5)

SCREENING BERM (SEE NOTE 9)

PARTIAL YARD PIPING AND PLANT DRAIN PIPING (TYP. SEE NOTE 1.h)

DIGESTION FACILITY #620
INSTALL EXCAVATION, MUD-MAT AND UNDERSLAB PIPING (SEE NOTE 6 AND 620-DWGS)

PLANT DRAIN PUMP STATION #700
INSTALL WET WELL AND PIPING STUBS (SEE 700-DWGS)

THICKENING BUILDING #610
STUB RAS PIPING

SECONDARY CLARIFIERS SPILLTER BOX #430
INSTALL UNDERSLAB PIPING (SEE NOTE 6 AND 430-DWGS)

SECONDARY CLARIFIERS #440
INSTALL EXCAVATION, MUD-MAT AND UNDERSLAB PIPING (SEE NOTE 6 AND 440-DWGS)

PERIMETER SWALE TO EXIST POND (SEE NOTE 3)

PROPERTY BOUNDARY (TYP)

VEHICLE STAGING AND TURN-AROUND PRIOR TO ENTRY GATE

STORMWATER BYPASS CULVERTS

OPERATIONS BUILDING #050 (SEE NOTE 2 AND 050-DWGS)

NATURAL GAS SERVICE CONNECTION TO OPERATIONS BUILDING (SEE NOTE 7)

BIOREACTOR SPLITTER BOX #410
INSTALL UNDERSLAB PIPING (SEE NOTE 6 AND 410-DWGS)

BIOREACTORS #420
INSTALL EXCAVATION, MUD-MAT AND UNDERSLAB PIPING (SEE NOTE 6 AND 420-DWGS)

INSTALL SILT FENCE, COMPOST-FIBER CHECK DAMS AND OTHER EROSION CONTROL MEASURES

WET STORMWATER POND AND PARTIAL STORMWATER PIPING AND INLETS (SEE NOTE 4)

EXIST POND REMAINS

SCREENING BERM (SEE NOTE 9)

PT #4 IPINS
N: 714245.69
E: 1720305.02
Z EL: 1006.74

AND OHIO WATER AND SEWER DISTRICT
P.L.D. 05-05224.000
41.48 ACRE
D.B. 421 PG. 1598

MCMURRAY RYAN 1/2 & CLUCKEY ELIZABETH E 1/2
P.L.D. 05-00156.000
91.58 ACRE
D.B. 332 PG. 645

MCMURRAY RYAN 1/2 & CLUCKEY ELIZABETH E 1/2
P.L.D. 05-00156.000
91.58 ACRE
D.B. 332 PG. 645

SCHROCK, PAUL W. TRUSTEE
P.L.D. 05-05214.000
13.53 ACRE
D.B. 421 PG. 1598

Jacobs
CIVIL

EARLY SITE PACKAGE
OVERALL PLAN


1" = 200'	
VERIFY SCALE	
BAR IS ONE INCH ON ORIGINAL DRAWING.	
DATE	2025/08/01
PROJ	C6A24900
DWG	005-C-150

PTI DOCUMENT

DEER CREEK WRF
Mid-Ohio Water and Sewer District
London - OH

NO.	DATE	DR	CHK	APVD	BY	APRV
		T. MALONE	P. MEDEJ	J. RAMOS	T. MALONE	

REUSE OF DOCUMENTS: THIS DOCUMENT AND THE IDEAS AND DESIGNS INCORPORATED HEREIN, AS AN INSTRUMENT OF PROFESSIONAL SERVICE, IS THE PROPERTY OF JACOBS AND IS NOT TO BE USED, IN WHOLE OR IN PART, FOR ANY OTHER PROJECT WITHOUT THE WRITTEN AUTHORIZATION OF JACOBS. © JACOBS 2018. ALL RIGHTS RESERVED.

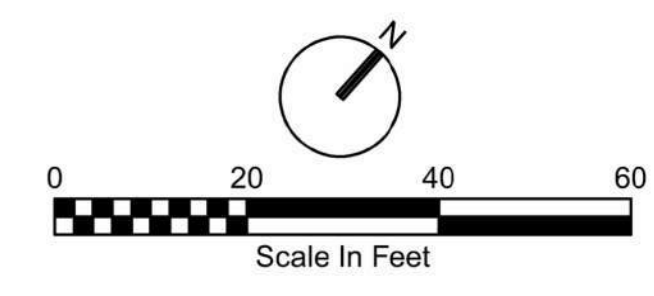


- ### NOTES
1. THE EARLY SITE PACKAGE GRADING GENERALLY COINCIDES WITH THE FINAL SITE AND ROAD GRADES AS ENVISIONED PRIOR TO THE 60% DESIGN LEVEL. CHANGES TO SITE GRADING, ROAD ELEVATIONS, AND THE STORMWATER SYSTEM MAY BE NEEDED IN FUTURE DESIGN PHASES.
 2. THE STORMWATER STRUCTURE AND PLANT DRAIN MANHOLE SCHEDULE ARE SUBJECT TO CHANGE BASED ON POTENTIAL FUTURE REVISIONS. FINAL SCHEDULES FOR THE STORMWATER STRUCTURES AND PLAN DRAIN MANHOLES WILL BE RELEASED IN A FUTURE PHASE.
 - 3A. THE PROPOSED AGGREGATE CONSTRUCTION ROADS GENERALLY ALIGN WITH THE FINAL PAVED ROADS. CONSTRUCTION ROAD LOCATIONS, AND AGGREGATE SURFACES TYPE AND THICKNESS ARE BY CMAR.
 - 3B. FOR REFERENCE, THE FINAL PAVED ROAD PAVEMENT SECTION WILL CONSIST OF:
 - 5 INCHES OF ASPHALT, ODOT ITEM 441
 - 10 INCHES AGGREGATE BASE, ODOT ITEM 304
 - 12 INCHES COMPACTED SUBGRADE
 4. THE STAGING AREAS ARE OUTSIDE ACTIVE CONSTRUCTION AREAS EXCEPT FOR ROUGH GRADING. THE ACTUAL STAGING AREA LOCATION AND SIZE AND ASSOCIATED STABILIZATION ARE BY CMAR.
 5. PRELIMINARY PIPE PROFILES FOR STORMWATER (STM) ARE ON DWGS 005-C-301 TO 005-C-303. PIPE PROFILES FOR PLANT DRAIN (DR) ARE ON DWGS 005-Y-301 TO 005-Y-302.

NO.	DATE	DR	CHK	APVD	BY
		T. MALONE	P. MADEJ	J. RAMOS	T. MALONE
		DSGN	DSGN	APRV	APRV


- ### STORMWATER STRUCTURE SCHEDULE
- NOTES
1. SEE NOTE 2.
 2. INSTALL COMPOST FIBER LOGS, DETAIL 3125-185, AROUND CATCH BASINS DURING CONSTRUCTION AS NEEDED TO LIMIT SEDIMENT INTRUSION.
- S1-151**
 CATCH BASIN
 ODOT SCD 2-3
 SEE DETAIL 3344-780
 TOP = 1008.80
 SE INV = 1001.50

DEER CREEK WRF
Mid-Ohio Water and Sewer District
London - OH

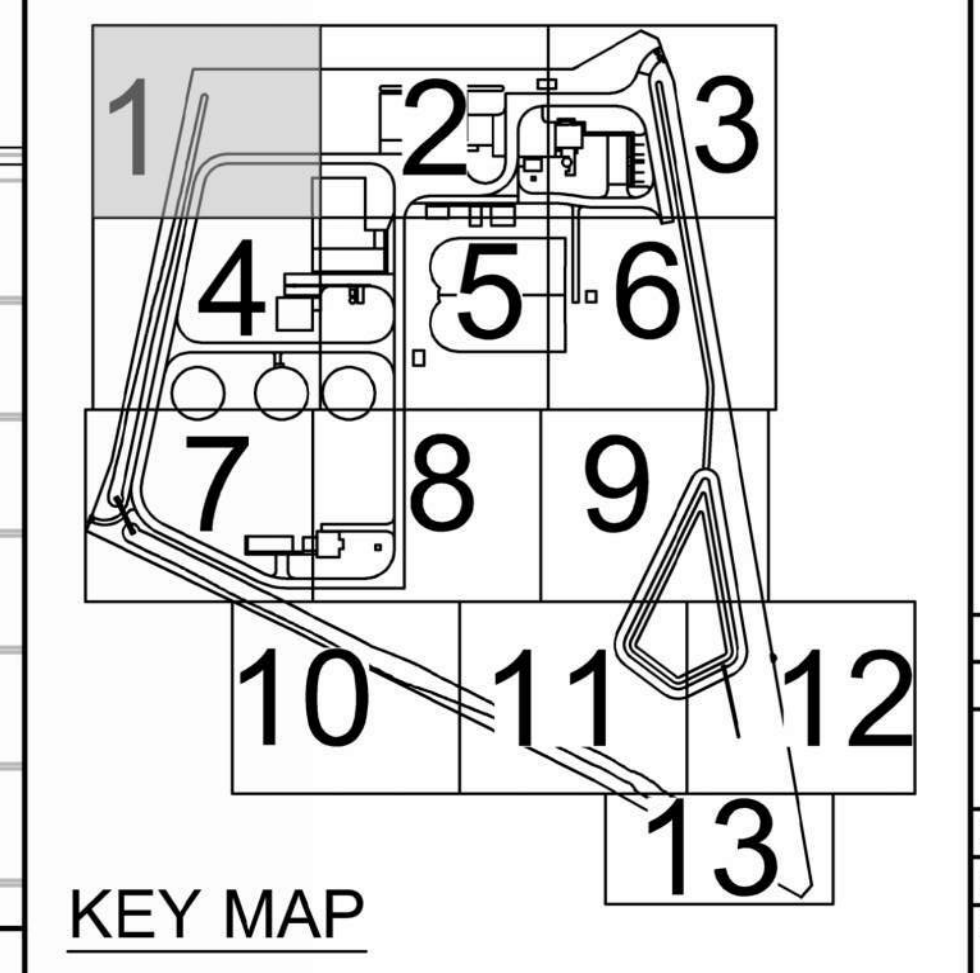

KEY MAP

- PROPERTY LINE (TYP)
- SCREENING BERM FOR SPOILS (3 FT HIGH, 3:1 SIDE SLOPES & 2 FT WIDE TOP, SEED AND MULCH)
- 4' WIDE PEDESTRIAN GATE (MATCH FENCE STYLE) (3213-420)
- 6' HIGH BLACK VINYL CHAIN LINK FENCE WITH BARBED WIRE (TYP, 2.5 FT FROM NORTH AND WEST PROPERTY) (3213-410)
- SEED AND MULCH DISTURBED AREAS THROUGH-OUT CONSTRUCTION (TYP)
- COMPOST FIBER CHECK DAM (100 FT SPACING, TYP) (3125-185)
- 20' AGGREGATE CONSTRUCTION ROAD (SEE NOTE 3A & B)
- 347' - 18" STM-CPE @ 0.50% (SEE NOTES 2 & 5)
- WEST PERIMETER DIVERSION SWALE TO CONVEY OFFSITE FLOW (SEE NOTE 3 ON DWG 005-C-150)

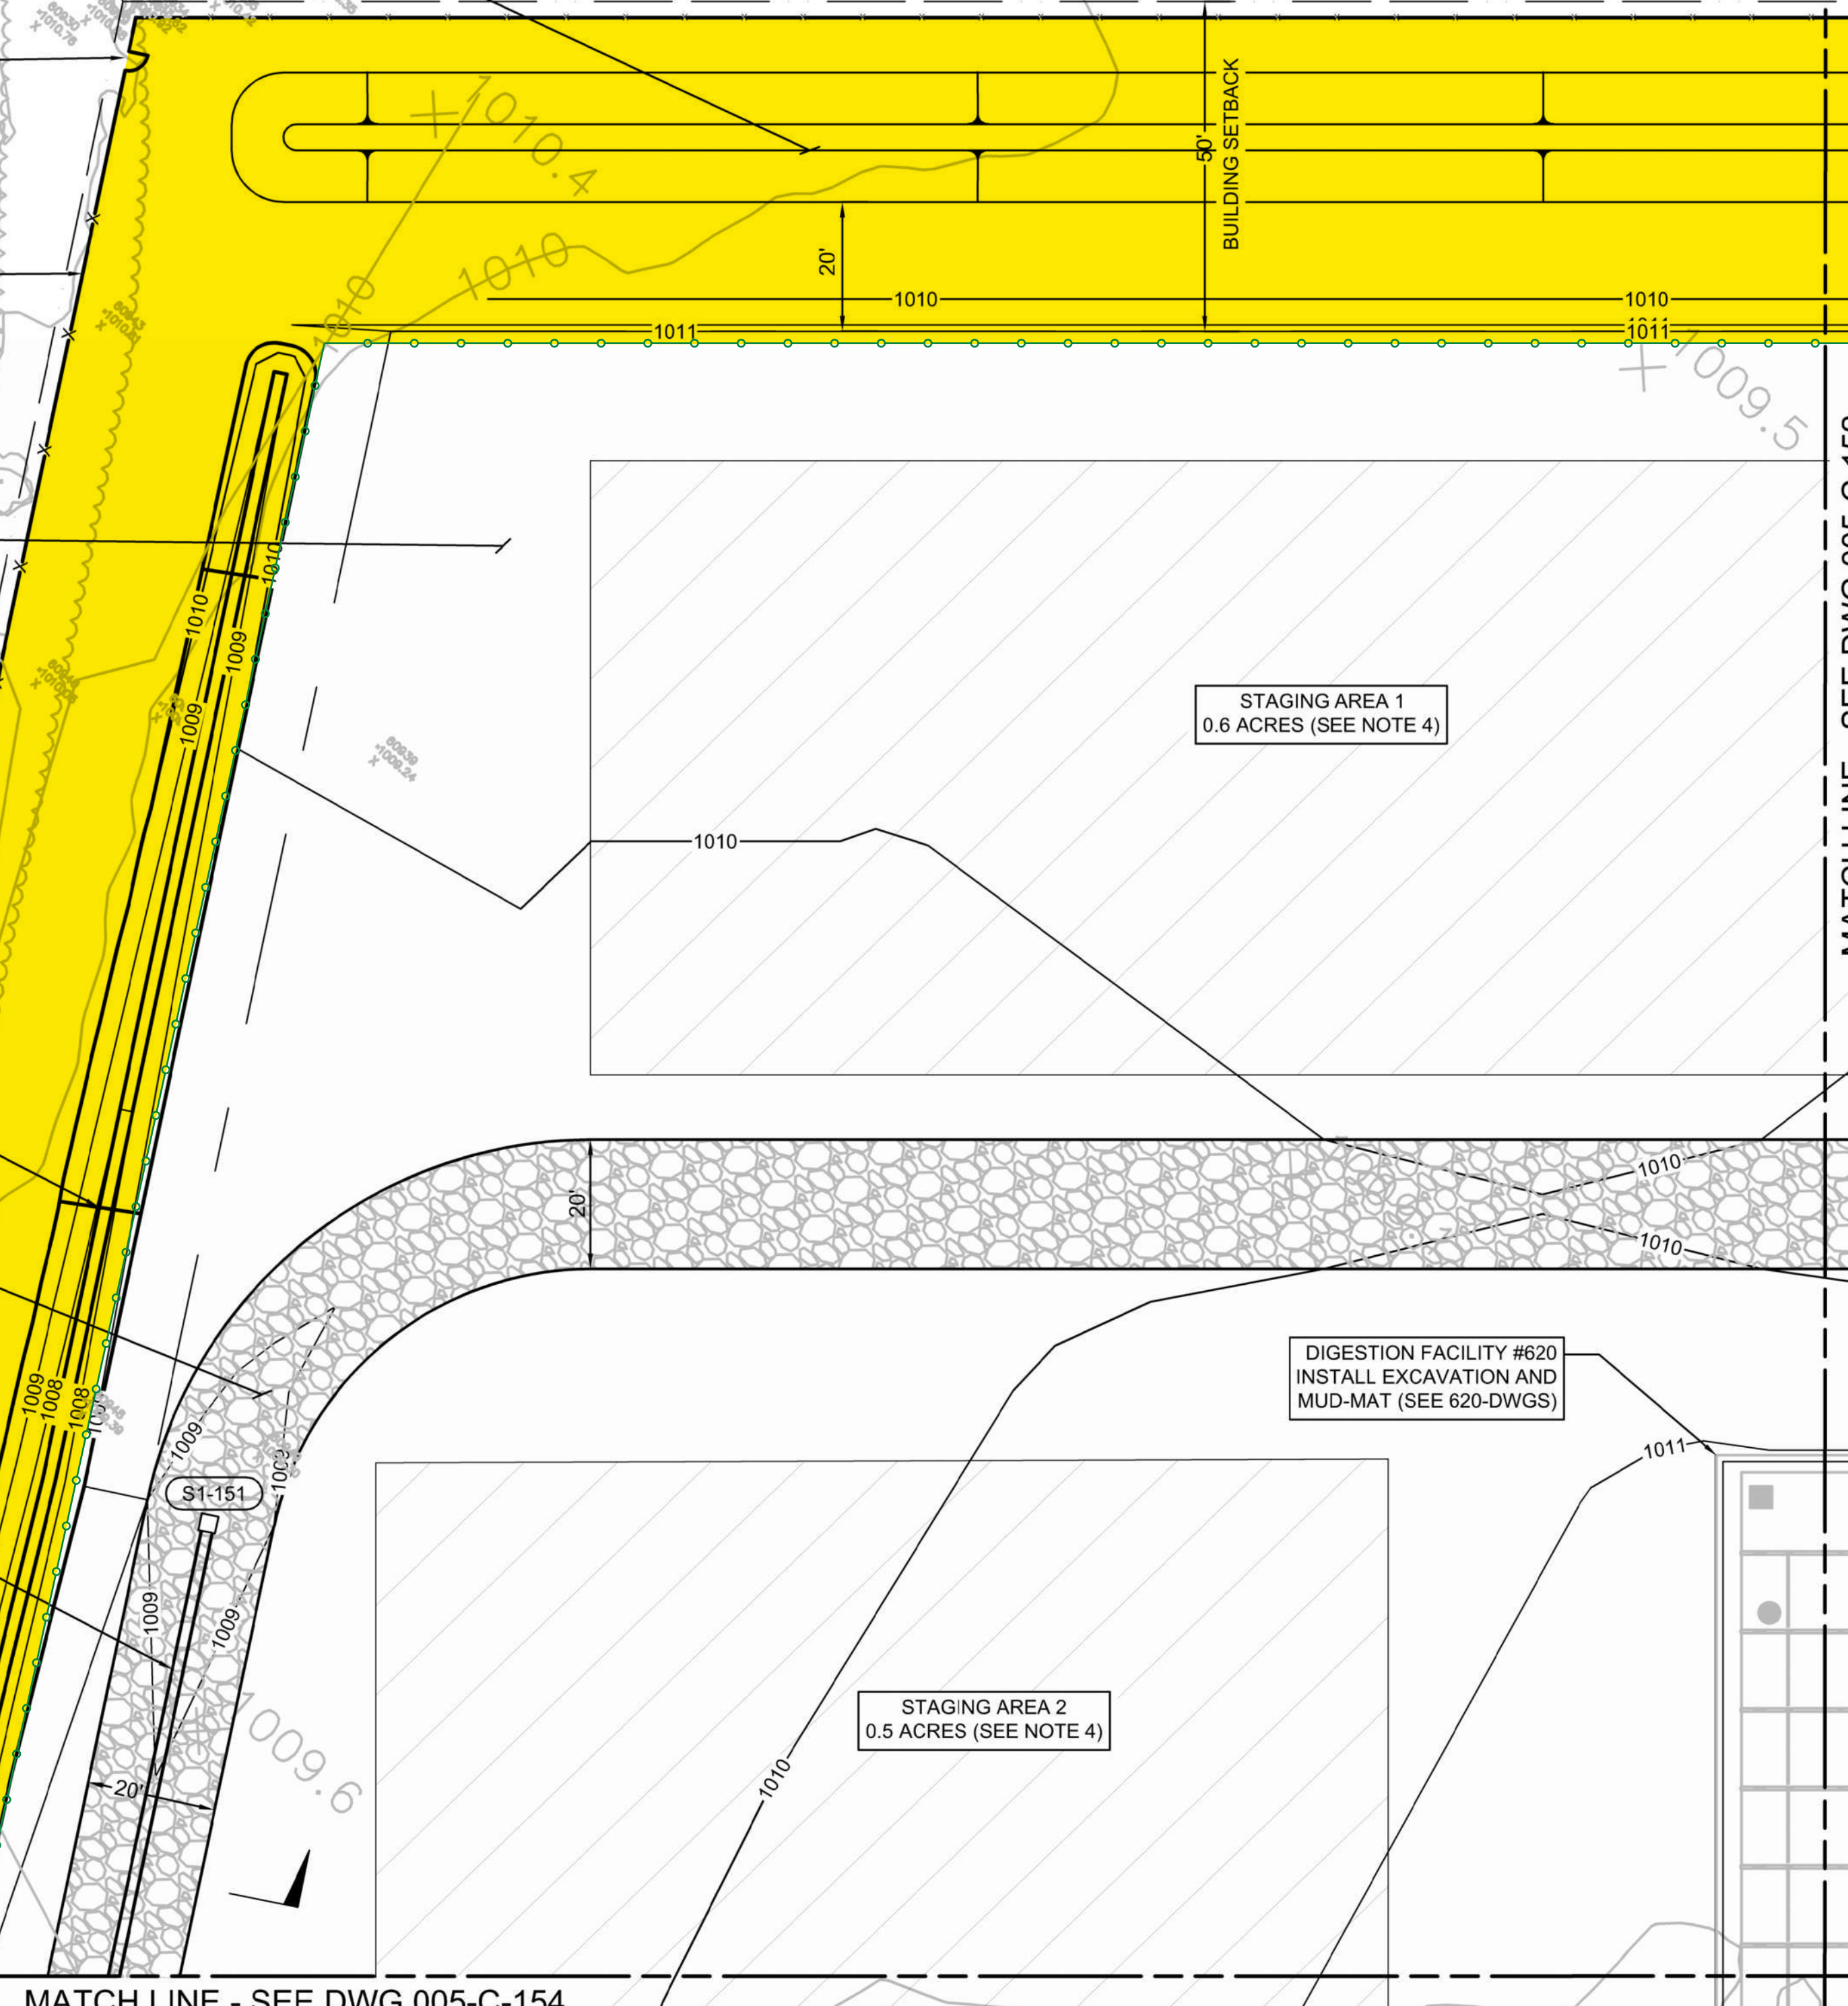

MATCH LINE - SEE DWG 005-C-154

MATCH LINE - SEE DWG 005-C-152



Jacobs

CIVIL

EARLY SITE PACKAGE
SITE PLAN
SHEET 1

1" = 20'
VERIFY SCALE
BAR IS ONE INCH ON ORIGINAL DRAWING.

DATE	2025/08/01
PROJ	C6A24900
DWG	005-C-151

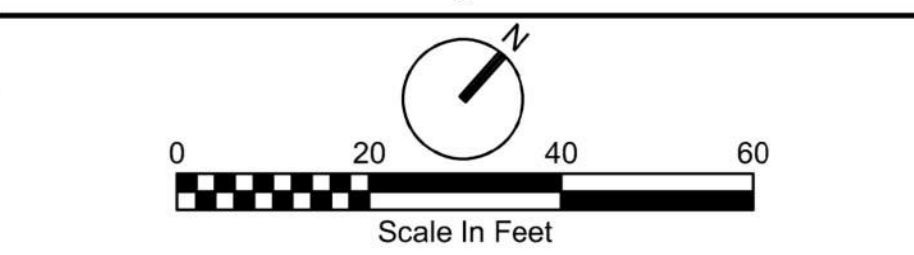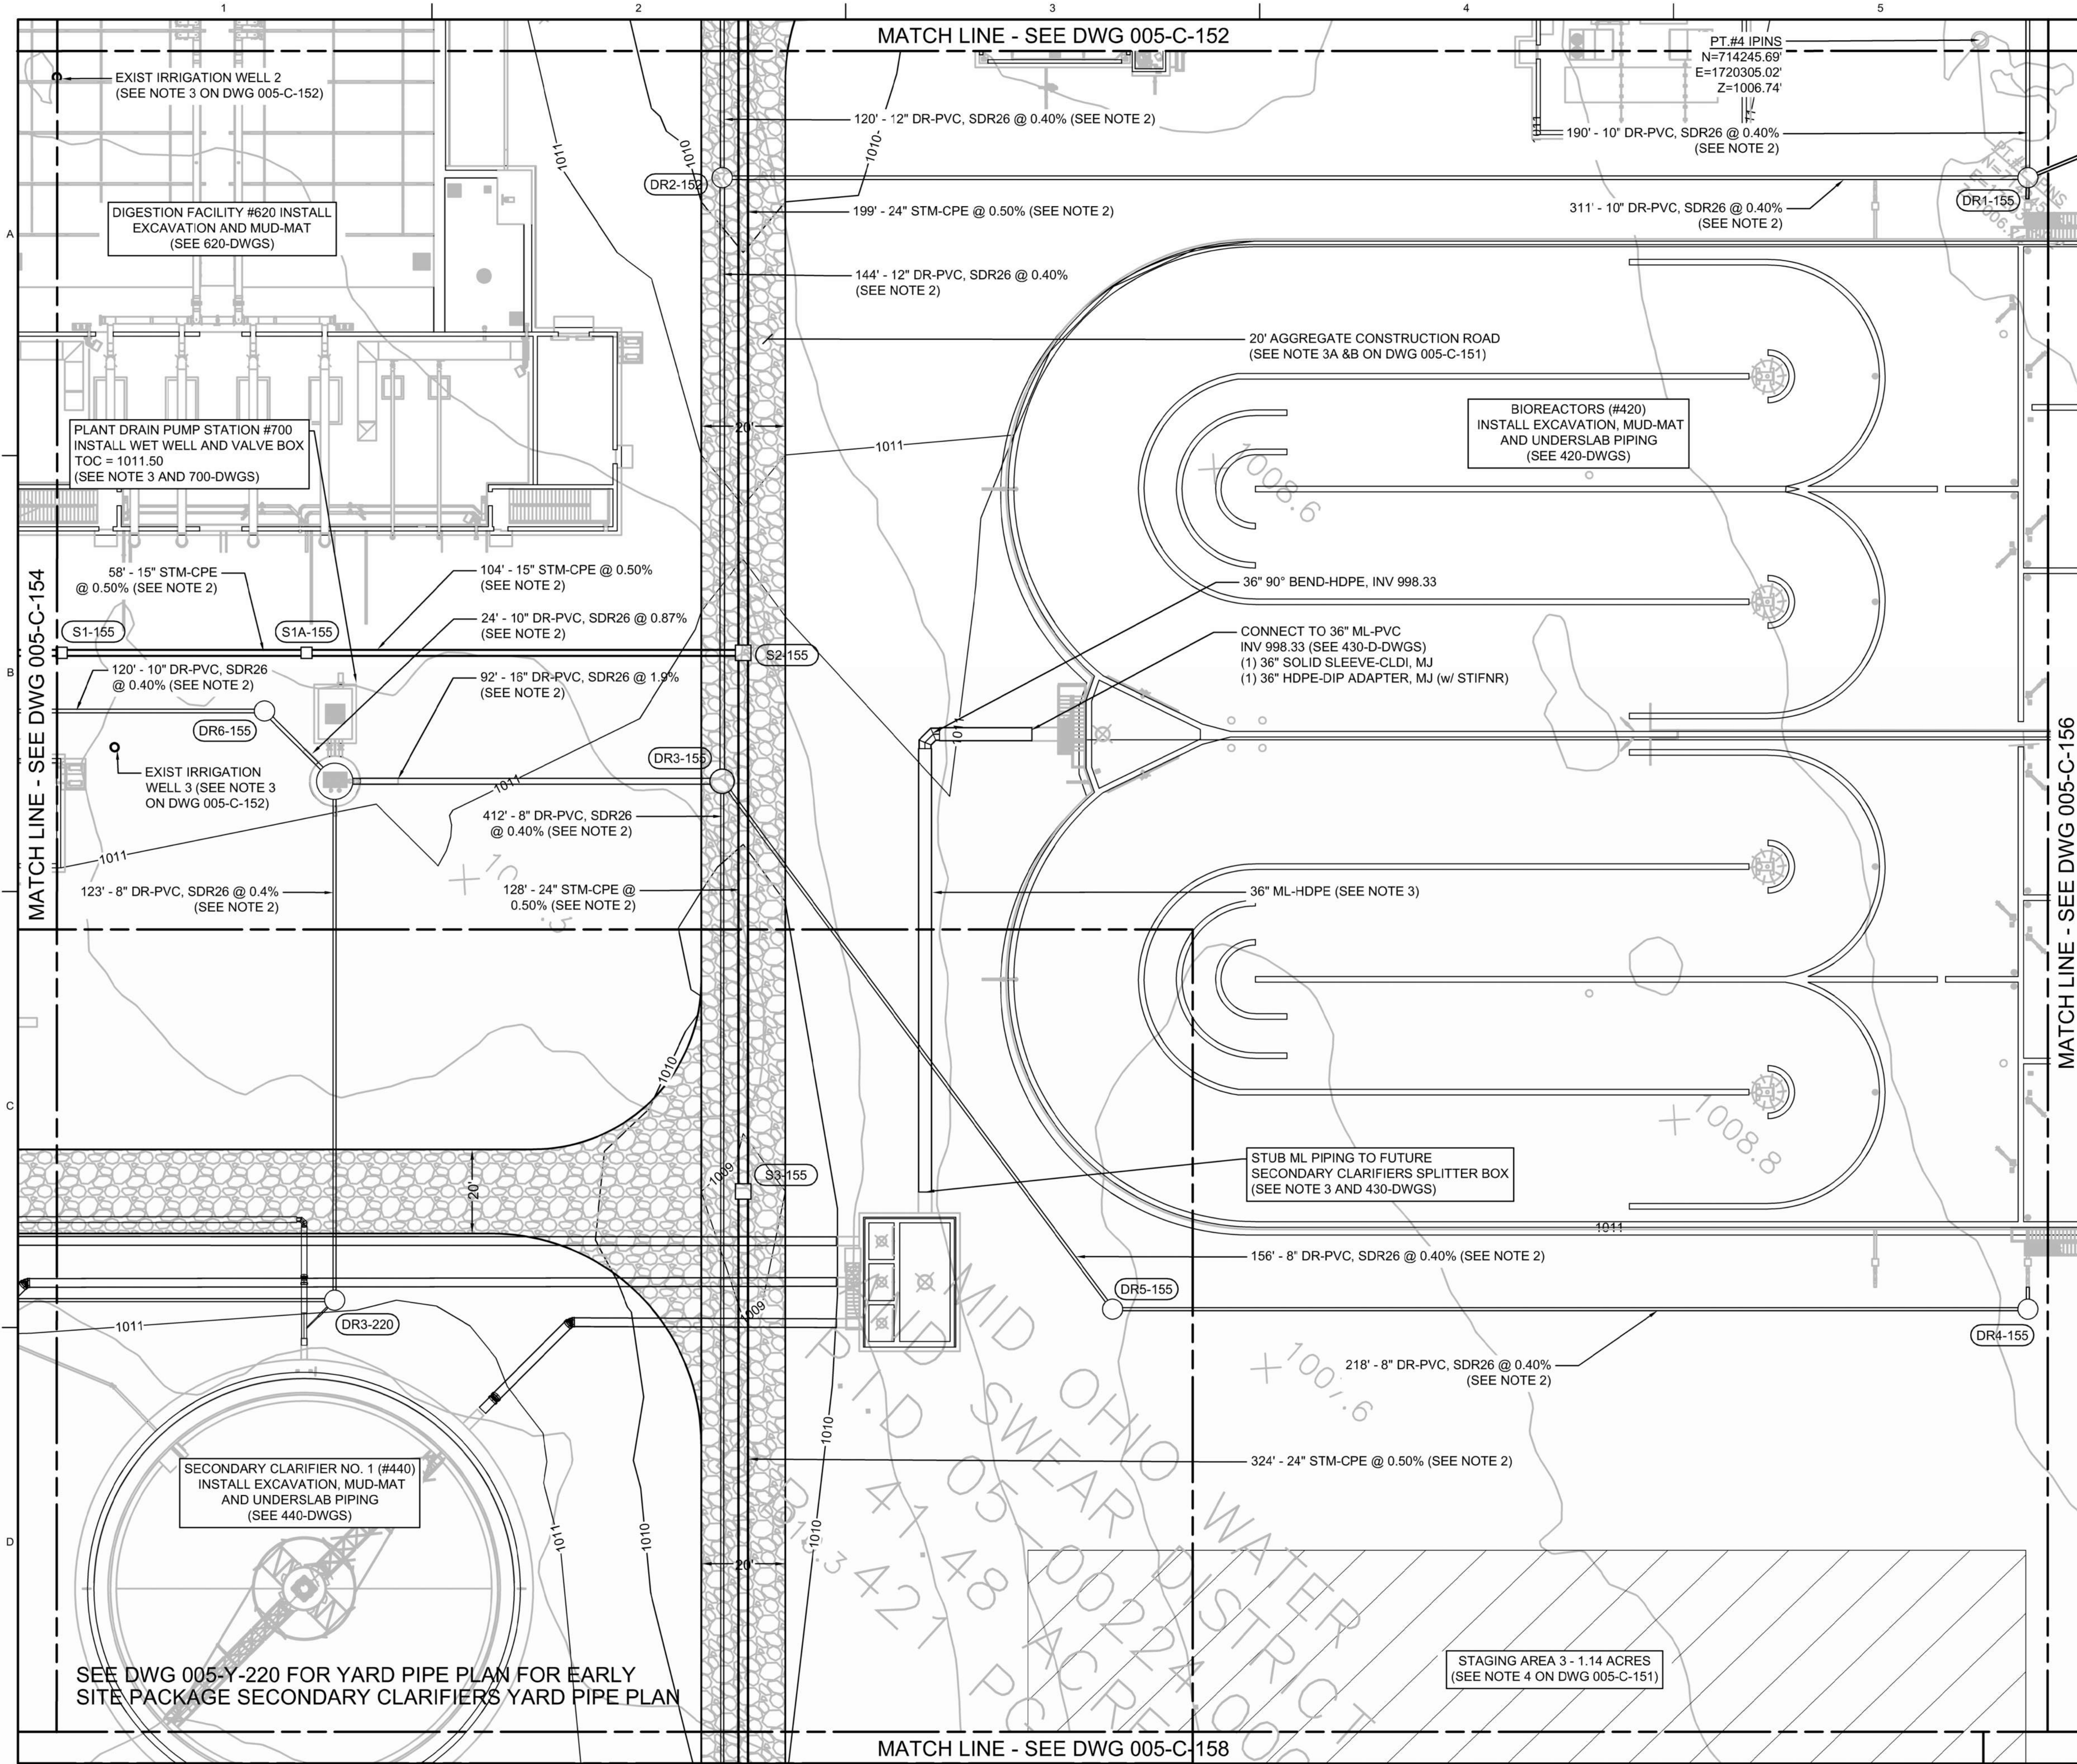

NOTES

- SEE NOTES ON SITE PLAN SHEET 1, DWG 005-C-151.
- THE STORMWATER AND PLANT DRAIN SYSTEM ARE PRELIMINARY. THE FINAL DESIGN WILL BE RELEASED IN A FUTURE PHASE. FOR PRELIMINARY PIPE PROFILES FOR STORMWATER (STM), SEE DWGS 005-C-301 TO 005-C-303. PIPE PROFILES FOR PLANT DRAIN (DR) ARE ON DWGS 005-Y-301 TO 005-Y-302.
- YARD PIPING LAYOUT AND INVERTS FOR EARLY SITE PACKAGE, INCLUDING 30" ML AND 20" RAS, TO BE FINALIZED IN LATER PHASE.

PLANT DRAIN MANHOLE SCHEDULE

SUBJECT TO CHANGE, SEE NOTE 2


NO.	DATE	DR	CHK	DSGN	BY	APRV
DR1-155						
DR2-155						
DR3-155						
DR4-155						
DR5-155						
DR6-155						

STORMWATER STRUCTURE SCHEDULE

1. SUBJECT TO CHANGE, SEE NOTE 2.

2. INSTALL COMPOST FIBER LOGS, DETAIL 3125-185, AROUND CATCH BASINS DURING CONSTRUCTION AS NEEDED TO LIMIT SEDIMENT INTRUSION.

NO.	DATE	DR	CHK	DSGN	BY	APRV
S1-155						
S2-155						
S3-155						

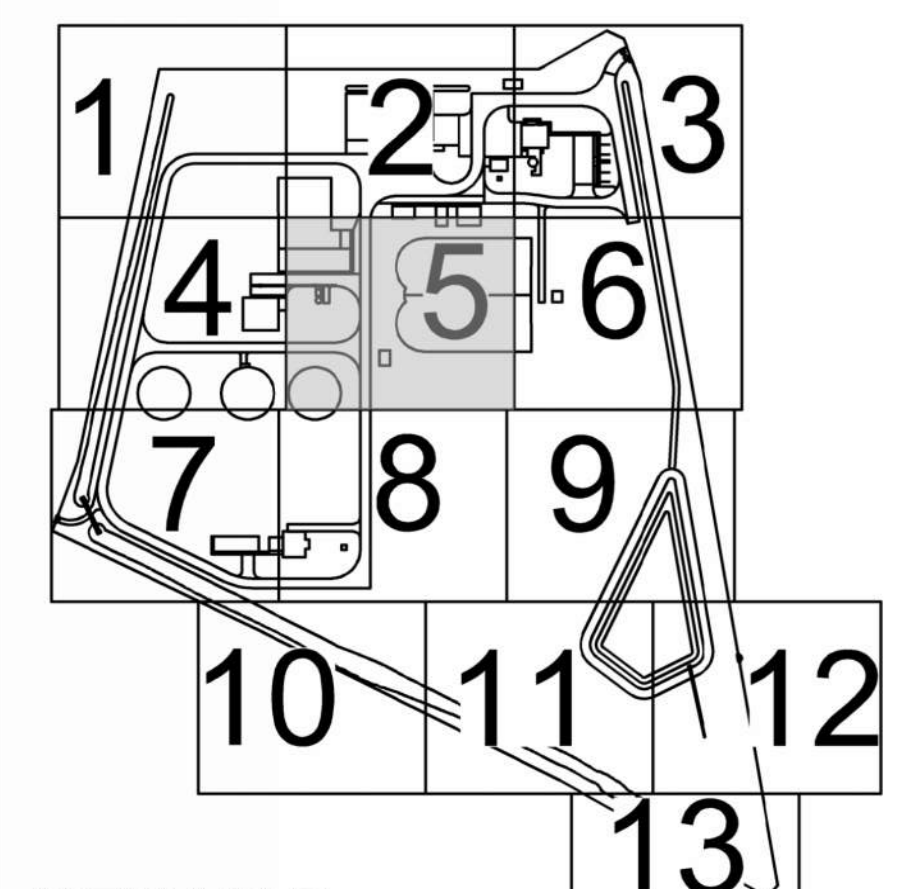

KEY MAP

JACOBS

CIVIL
EARLY SITE PACKAGE
SITE PLAN
SHEET 5

DEER CREEK WRF
Mid-Ohio Water and Sewer District
London - OH


1" = 20'
VERIFY SCALE
BAR IS ONE INCH ON ORIGINAL DRAWING.

DATE	2025/08/11
PROJ	C6A24900
DWG	005-C-155

PTI DOCUMENT

REUSE OF DOCUMENTS: THIS DOCUMENT, AND THE IDEAS AND DESIGNS INCORPORATED HEREIN, AS AN INSTRUMENT OF PROFESSIONAL SERVICE, IS THE PROPERTY OF JACOBS AND IS NOT TO BE USED, IN WHOLE OR IN PART, FOR ANY OTHER PROJECT WITHOUT THE WRITTEN AUTHORIZATION OF JACOBS. © JACOBS 2018. ALL RIGHTS RESERVED.

MATCH LINE - SEE DWG 005-C-153

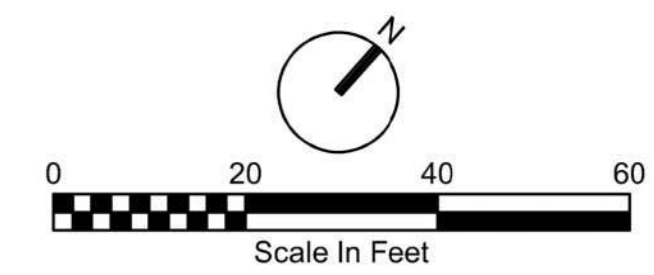


- ### NOTES
- SEE NOTES ON SITE PLAN SHEET 1, DWG 005-C-151.
 - THE STORMWATER AND PLANT DRAIN SYSTEM ARE PRELIMINARY. THE FINAL DESIGN WILL BE RELEASED IN A FUTURE PHASE. FOR PRELIMINARY PIPE PROFILES FOR STORMWATER (STM), SEE DWGS 005-C-301 TO 005-C-303. PIPE PROFILES FOR PLANT DRAIN (DR) ARE ON DWGS 005-Y-301 TO 005-Y-302.
 - YARD PIPING LAYOUT AND INVERTS FOR EARLY SITE PACKAGE, INCLUDING 30" SRS, TO BE FINALIZED IN LATER PHASE.

YARD PIPE FITTING SCHEDULE

NOTE: SUBJECT TO CHANGE, SEE NOTE 2.

1	(1) 30" SOLID SLEEVE-CLDI, MJ (1) 30" HDPE-DIP ADAPTER, MJ (w/ STIFFENER)
2	30" 90° BEND-HDPE

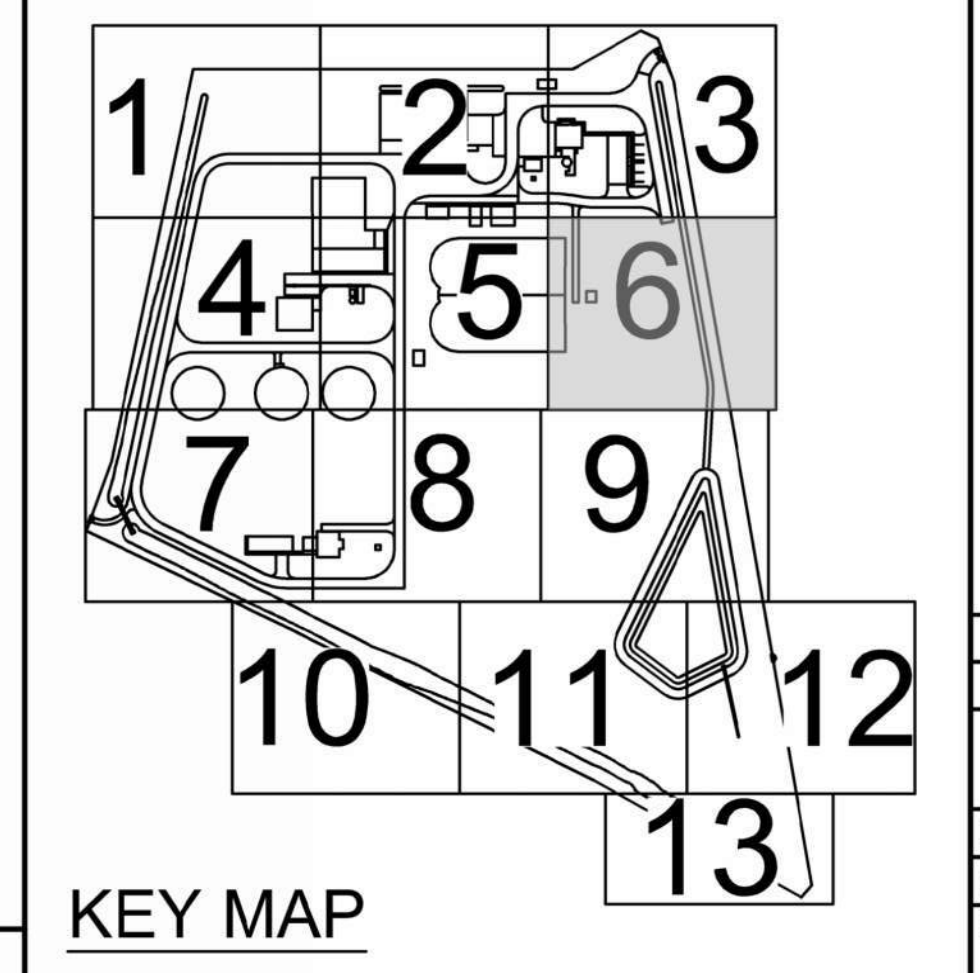

NO.	DATE	DR	CHK	APVD	BY	APRV
		T. MALONE	P. MADEJ	J. RAMOS		T. MALONE

Jacobs CIVIL

EARLY SITE PACKAGE
SITE PLAN
SHEET 6

DEER CREEK WRF
Mid-Ohio Water and Sewer District
London - OH

1" = 20'
VERIFY SCALE
BAR IS ONE INCH ON ORIGINAL DRAWING.

DATE 2025/08/01
PROJ C6A24900
DWG 005-C-156

PTI DOCUMENT

MATCH LINE - SEE DWG 005-C-159

172" - 8" DR-PVC, SDR26 @ 0.40%
(SEE NOTE 2)

20' AGGREGATE CONSTRUCTION ROAD
(SEE NOTE 3A & B, DWG 005-C-151)

PROPERTY LINE (TYP)

6' HIGH BLACK VINYL CHAIN LINK FENCE WITH
BARBED WIRE (TYP, 2.5 FT FROM EAST PROPERTY
LINE. LOCATE AND PROTECT GAS MAIN)
(3213-410)

SILT FENCE (INSIDE CHAIN LINK FENCE) (3125-165)

COMPOST FIBER CHECK DAM (100-FT SPACING, TYP)
(3125-185)

EAST STORMWATER SWALE
(SEE SECTION 2, DWG 005-C-304)

NATURAL GAS PIPE MARKER POST
(100 FT INTERVALS AND CHANGES
IN DIRECTION, TYP)
(3305-960)

EXIST 8" NATURAL GAS MAIN
AND 10' WIDE NATURAL GAS EASEMENT

EROSION BLANKET OVER SWALE
SHOWN CROSS-HATCHED.
BLANKET TO EXTEND 2 FT (MIN)
ABOVE SWALE BOTTOM.

BIOREACTORS (#420)
INSTALL EXCAVATION, MUD-MAT
AND UNDERSLAB PIPING
(SEE 420-DWGS)

30" ML-HDPE (SEE NOTE 3)

STUB ML PIPING TO FUTURE
SECONDARY CLARIFIERS
SPLITTER BOX (SEE NOTE 3
AND 430-DWGS)


STAGING AREA 4 - 1 ACRES
(SEE NOTE 4 ON DWG 005-C-151)

30" ML-HDPE (SEE NOTE 3)

MATCH LINE - SEE DWG 005-C-155

REUSE OF DOCUMENTS: THIS DOCUMENT, AND THE IDEAS AND DESIGNS INCORPORATED HEREIN, AS AN INSTRUMENT OF PROFESSIONAL SERVICE, IS THE PROPERTY OF JACOBS AND IS NOT TO BE USED, IN WHOLE OR IN PART, FOR ANY OTHER PROJECT WITHOUT THE WRITTEN AUTHORIZATION OF JACOBS. © JACOBS 2018. ALL RIGHTS RESERVED.

MATCH LINE - SEE DWG 005-C-154

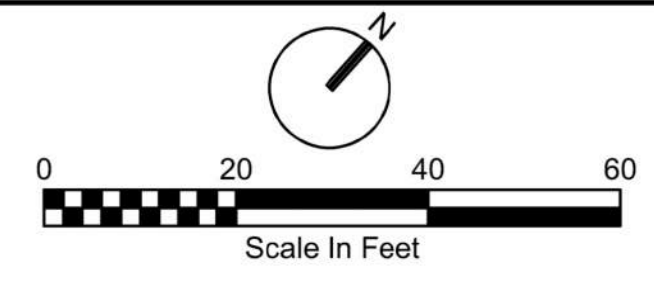

NOTES

- SEE NOTES ON SITE PLAN SHEET 1, DWG 005-C-151.
- THE STORMWATER AND PLANT DRAIN SYSTEM ARE PRELIMINARY. THE FINAL DESIGN WILL BE RELEASED IN A FUTURE PHASE. FOR PRELIMINARY PIPE PROFILES FOR STORMWATER (STM), SEE DWGS 005-C-301 TO 005-C-303. PIPE PROFILES FOR PLANT DRAIN (DR) ARE ON DWGS 005-Y-301 TO 005-Y-302.
- FUTURE EFFLUENT MAINS WILL BE ROUTED THROUGH THE SOUTH WEST PROPERTY CORNER. TEMPORARY FENCE MAY BE INSTALLED DURING THIS PHASE AND REPLACED WITH PERMANENT FENCING AFTER EFFLUENT MAIN INSTALLATION.


PLANT DRAIN MANHOLE SCHEDULE

NOTE: SUBJECT TO CHANGE, SEE NOTE 2.

(DR1-157)
4' DIA PRECAST MANHOLE
TYPE C MH, DETAIL 3305-710
TOP = 1009.04
NW INV = 1003.00*
NE INV = 998.66
* OUTSIDE DROP DETAIL 3305-712

STORMWATER STRUCTURE SCHEDULE

- NOTES
- SUBJECT TO CHANGE, SEE NOTE 2.
 - INSTALL COMPOST FIBER LOGS, DETAIL 3125-185, AROUND CATCH BASINS DURING CONSTRUCTION AS NEEDED TO LIMIT SEDIMENT INTRUSION.
- | | |
|---|---|
| (S1-157)
CATCH BASIN
ODOT SCD 2-3
TOP = 1009.43
NW INV = 998.36
SE INV = 998.36 | (S4-157)
CATCH BASIN
ODOT SCD 2-3
TOP = 1008.80
NE INV = 997.80
NW INV = 997.80
E INV = 997.80 |
| (S2-157)
CATCH BASIN
ODOT SCD 2-3
TOP = 1008.73
NE INV = 998.73
SW INV = 998.73 | (S5-157)
CATCH BASIN
ODOT SCD 2-3
TOP = 1007.65
W INV = 996.65
NE INV = 996.65 |
| (S3-157)
CATCH BASIN
ODOT SCD 2-3
TOP = 1008.25
NE INV = 997.96
SE INV = 997.96 | (S6-157)
HALF-HEIGHT HEADWALL
ODOT SCD HW-2.1
w/ CONC SLAB
INV = 1005.50 |
| | (S7-157)
HALF-HEIGHT HEADWALL
ODOT SCD HW-2.1
w/ CONC SLAB
INV = 1005.00 |

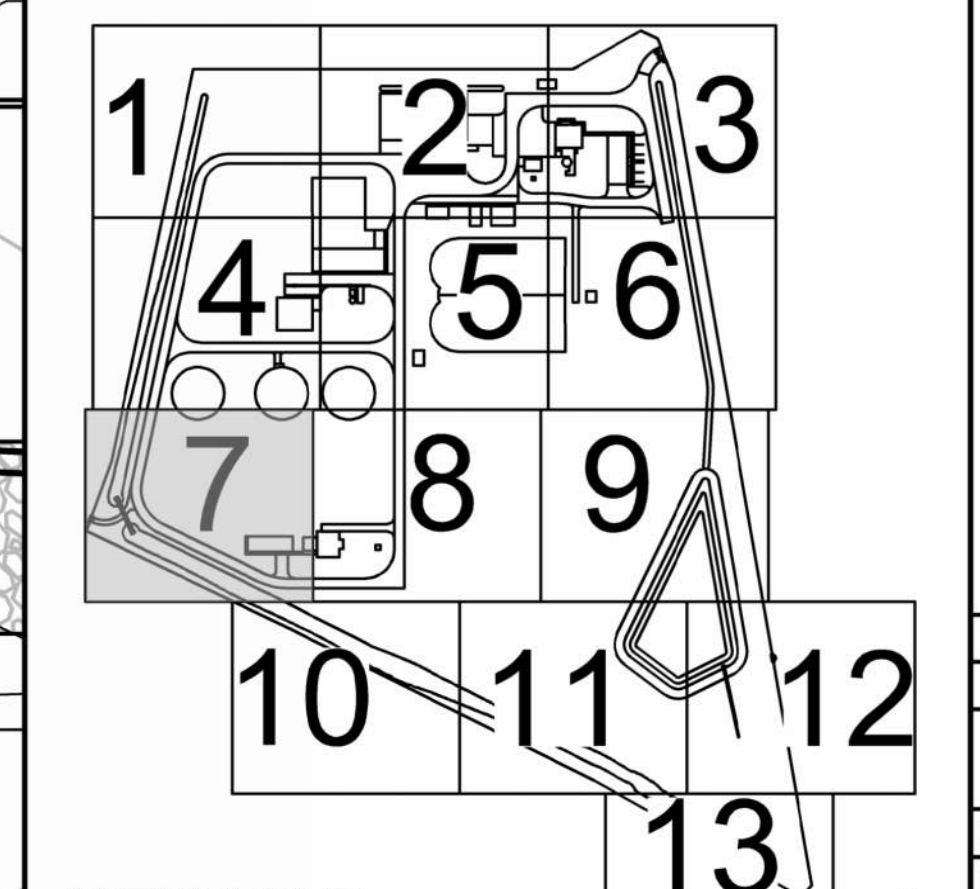

KEY MAP


NO.	DATE	DR	CHK	APVD	BY	APRV
		T. MALONE	P. MADEJ	J. RAMOS		T. MALONE

DEER CREEK WRF
Mid-Ohio Water and Sewer District
London - OH


Jacobs
CIVIL
EARLY SITE PACKAGE
SITE PLAN
SHEET 7

DATE	2025/08/01
PROJ	C6A24900
DWG	005-C-157

PTI DOCUMENT
REUSE OF DOCUMENTS: THIS DOCUMENT, AND THE IDEAS AND DESIGNS INCORPORATED HEREIN, AS AN INSTRUMENT OF PROFESSIONAL SERVICE, IS THE PROPERTY OF JACOBS AND IS NOT TO BE USED, IN WHOLE OR IN PART, FOR ANY OTHER PROJECT WITHOUT THE WRITTEN AUTHORIZATION OF JACOBS. © JACOBS 2018. ALL RIGHTS RESERVED.

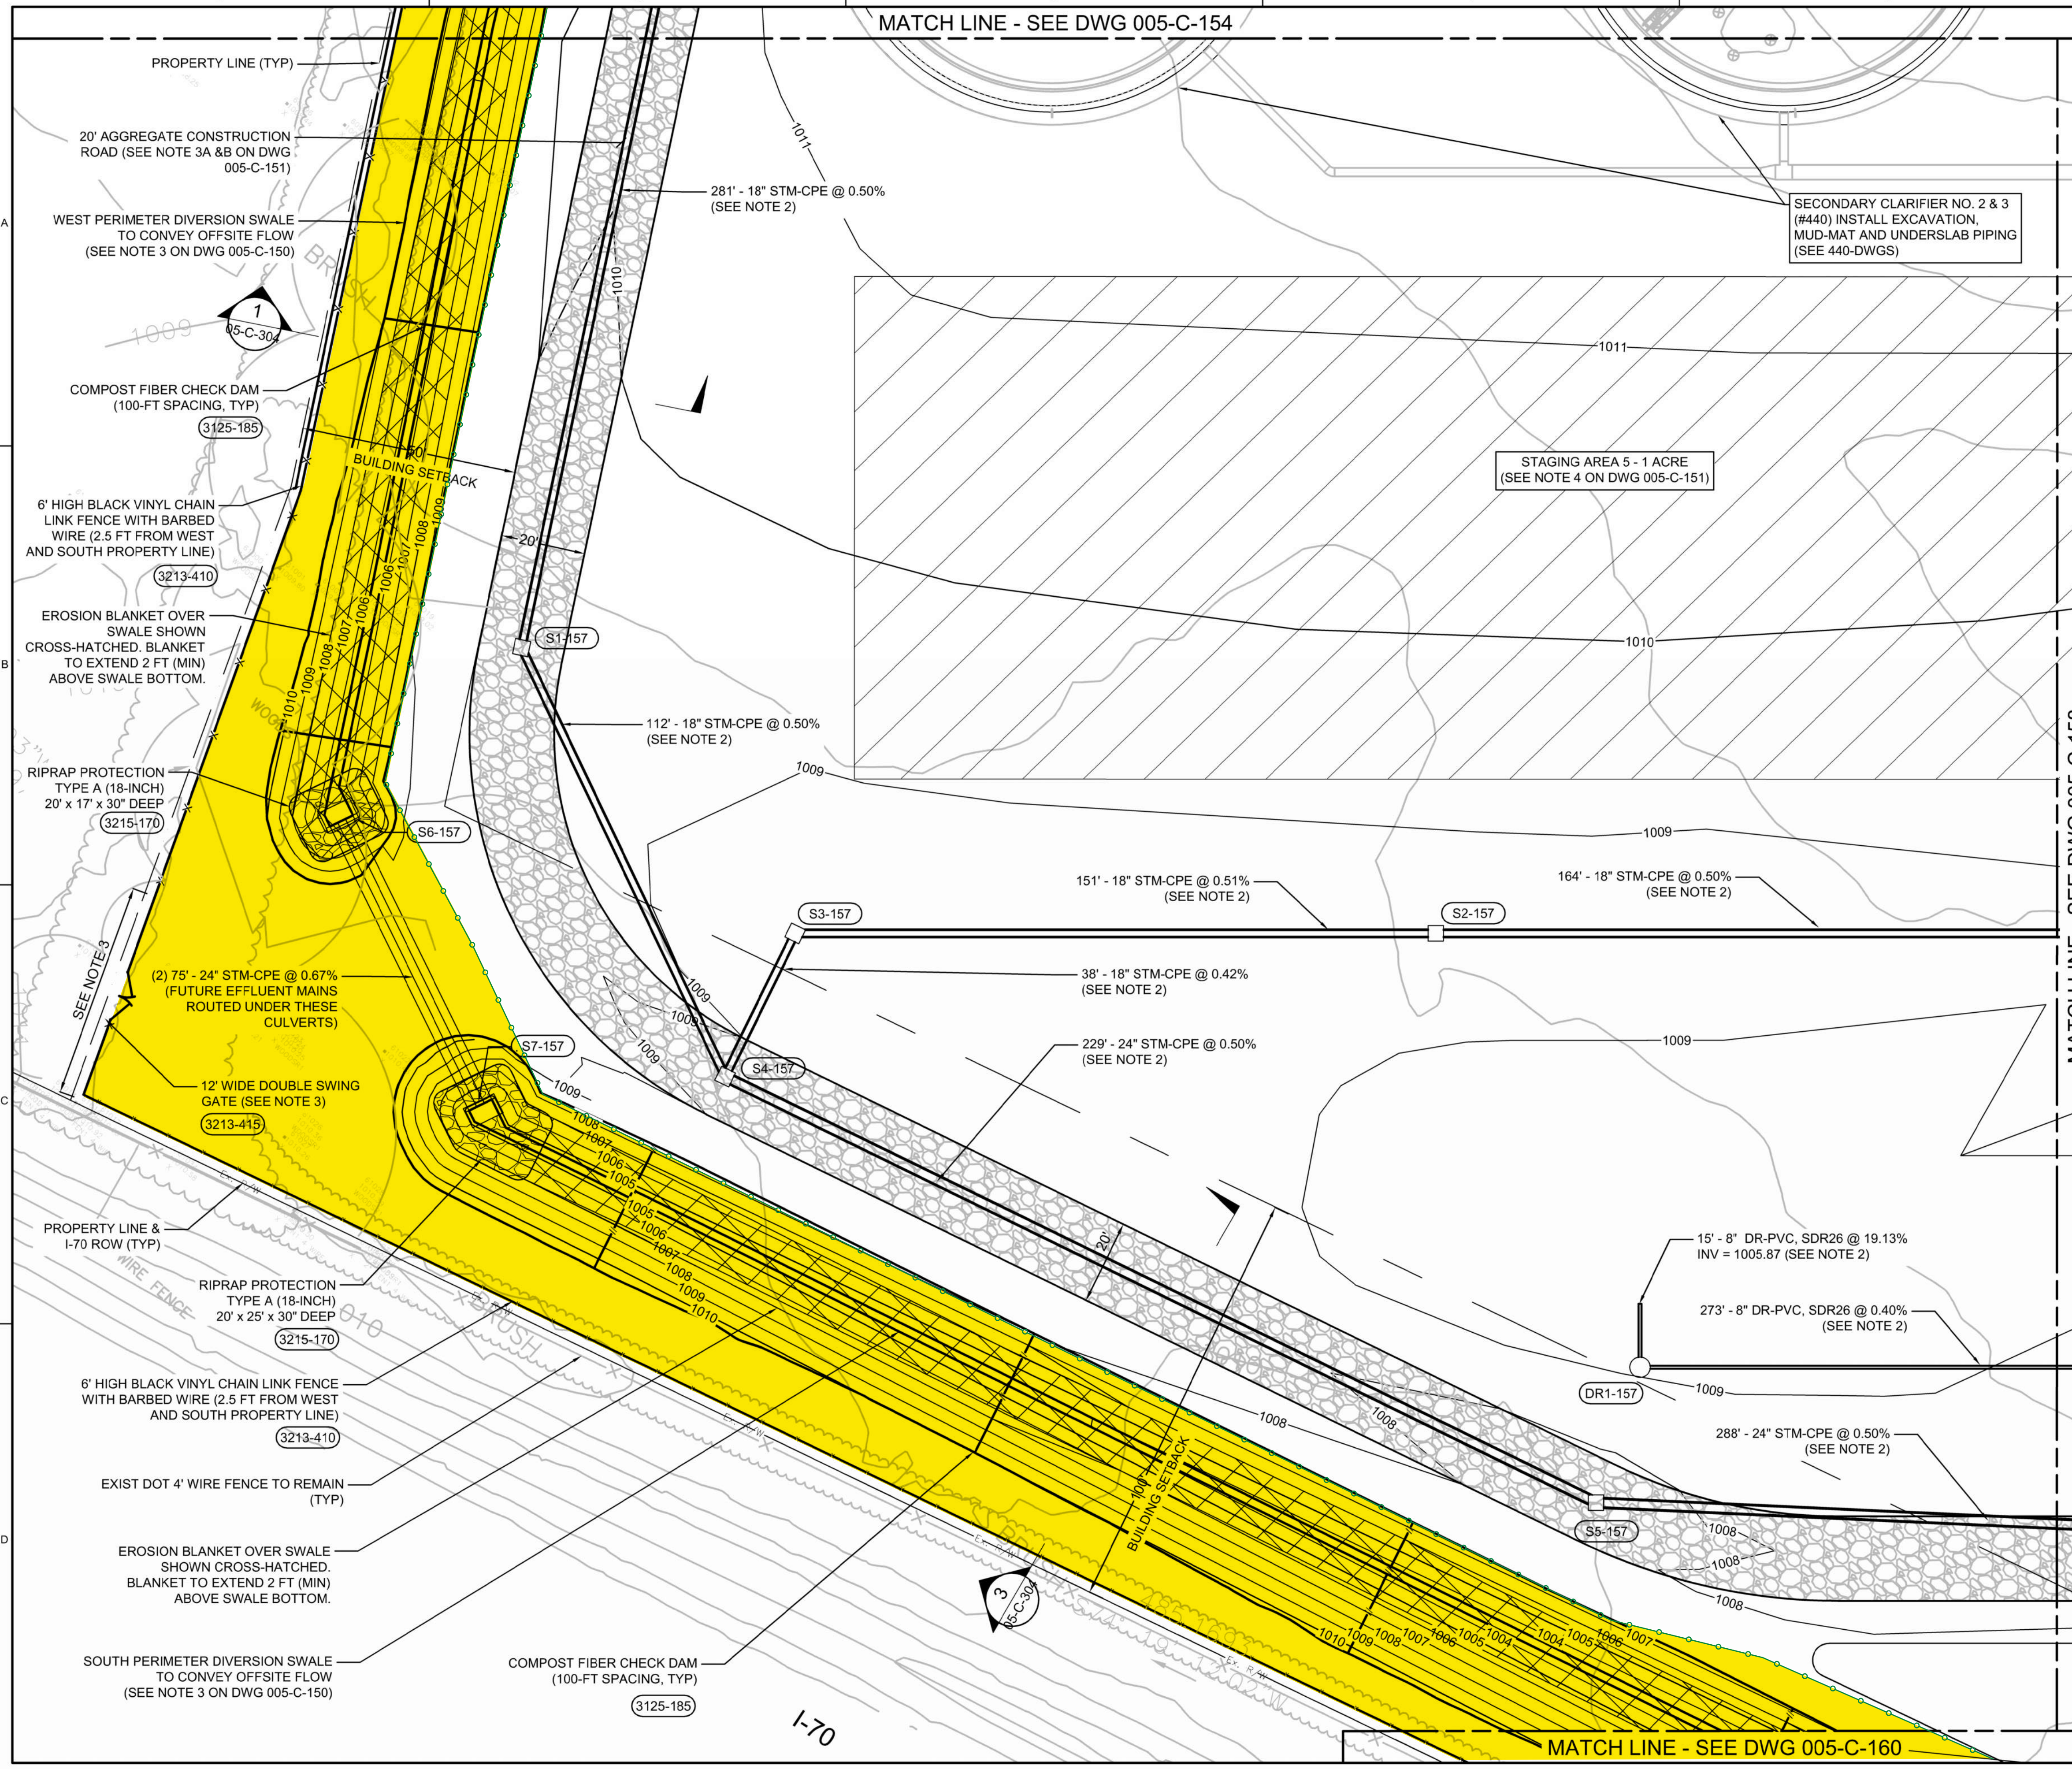

MATCH LINE - SEE DWG 005-C-155

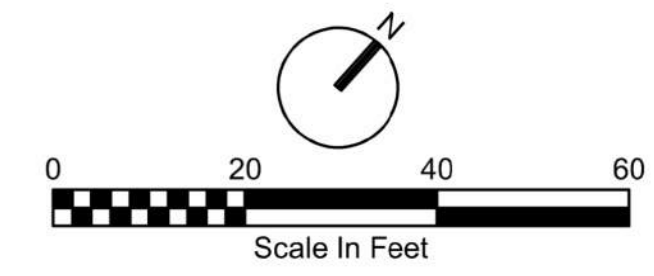

SECONDARY CLARIFIER NO. 1 (#440)
INSTALL EXCAVATION, MUD-MAT
AND UNDERSLAB PIPING
(SEE 440-DWGS)

STAGING AREA 3 - 1 ACRE
(SEE NOTE 4 ON DWG 005-C-151)

STAGING AREA 4 - 1 ACRE
(SEE NOTE 4 ON DWG 005-C-151)

20' AGGREGATE CONSTRUCTION ROAD
(SEE NOTE 3A & B ON DWG 005-C-151)

324' - 24" STM-CPE @ 0.50%
(SEE NOTE 2)

412' - 8" DR-PVC, SDR26 @ 0.40%
(SEE NOTE 2)

31' - 8" DR-PVC, SDR26 @ 0.40%
INV = 998.12 (SEE NOTE 2)

232' - 24" STM-CPE @ 0.50%
(SEE NOTE 2)

232' - 24" STM-CPE @ 0.50%
(SEE NOTE 2)

129' - 8" DR-PVC, SDR26 @ 0.40%
(SEE NOTE 2)

164' - 18" STM-CPE @ 0.50% (SEE NOTE 2)

273' - 8" DR-PVC, SDR26 @ 0.40%
(SEE NOTE 2)

288' - 24" STM-CPE @ 0.50%
(SEE NOTE 2)

226' - 24" STM-CPE
@ 0.49% (SEE NOTE 2)

SCREENING BERM FOR SPOILS
(4 FT HIGH 4:1 SIDE SLOPES,
SEED AND MULCH)

STAGING AREA 6 - 1 ACRE
(SEE NOTE 4 ON DWG 005-C-151)

MATCH LINE - SEE DWG 005-C-160

MATCH LINE - SEE DWG 005-C-161

NOTES

- SEE NOTES ON SITE PLAN SHEET 1, DWG 005-C-151.
- THE STORMWATER AND PLANT DRAIN SYSTEM ARE PRELIMINARY. THE FINAL DESIGN WILL BE RELEASED IN A FUTURE PHASE. FOR PRELIMINARY PIPE PROFILES FOR STORMWATER (STM), SEE DWGS 005-C-301 TO 005-C-303. PIPE PROFILES FOR PLANT DRAIN (DR) ARE ON DWGS 005-Y-301 TO 005-Y-302.

PLANT DRAIN MANHOLE SCHEDULE

NOTE: SUBJECT TO CHANGE, SEE NOTE 2.


NO.	DATE	DSGN	DR	CHK	APVD	BY	APRV
DR1-158					J RAMOS		
DR2-158					P MADEJ		
					T MALONE		

STORMWATER STRUCTURE SCHEDULE

NOTES

- SUBJECT TO CHANGE, SEE NOTE 2.
- INSTALL COMPOST FIBER LOGS, DETAIL 3125-185, AROUND CATCH BASINS DURING CONSTRUCTION AS NEEDED TO LIMIT SEDIMENT INTRUSION.

S1-158 CATCH BASIN ODOT SCD 2-3 TOP = 1009.53' NW INV = 995.05' NE INV = 995.05'	S3-158 CATCH BASIN ODOT SCD 2-3 TOP = 1008.75' SW INV = 999.55'
S2-158 CATCH BASIN ODOT SCD 2-3 TOP = 1009.33' SW INV = 993.9' NE INV = 993.9'	S4-158 CATCH BASIN ODOT SCD 2-3 TOP = 1008.00' SW INV = 995.22' E INV = 995.22'

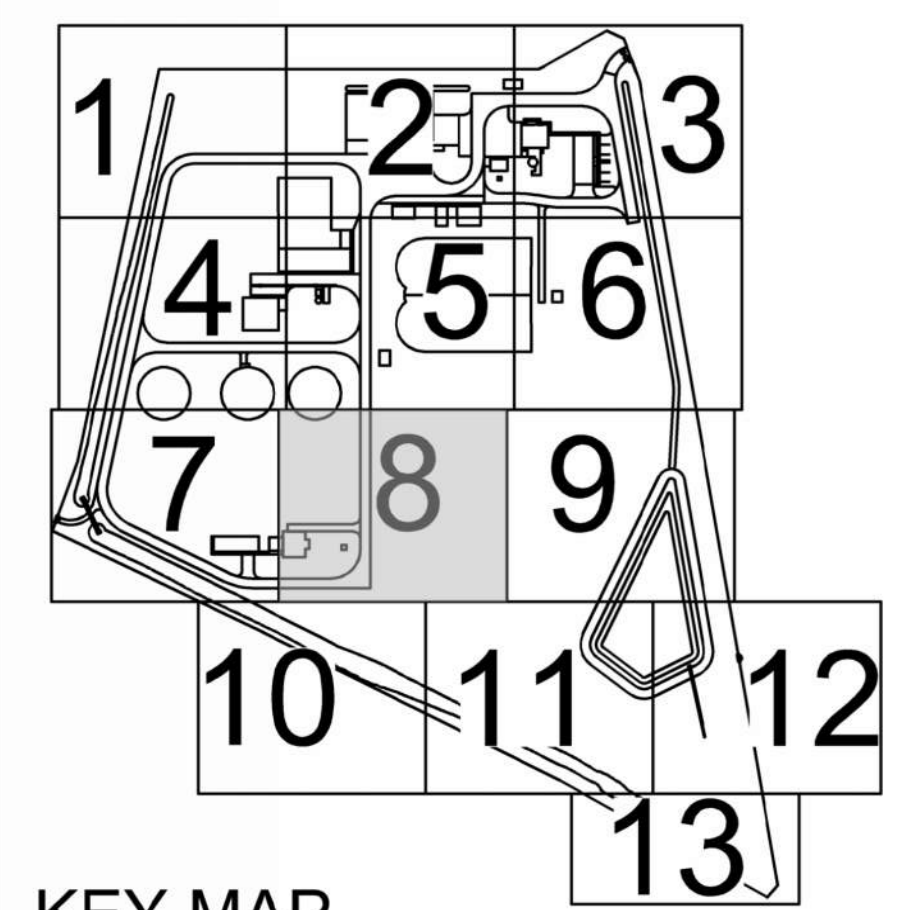

KEY MAP

Jacobs
CIVIL

EARLY SITE PACKAGE
SITE PLAN
SHEET 8

DEER CREEK WRF
Mid-Ohio Water and Sewer District
London - OH

1" = 20'
VERIFY SCALE
BAR IS ONE INCH ON ORIGINAL DRAWING.

DATE 2025/08/01
PROJ C6A24900
DWG 005-C-158

PTI DOCUMENT

REUSE OF DOCUMENTS: THIS DOCUMENT AND THE IDEAS AND DESIGNS INCORPORATED HEREIN, AS AN INSTRUMENT OF PROFESSIONAL SERVICE, IS THE PROPERTY OF JACOBS AND IS NOT TO BE USED, IN WHOLE OR IN PART, FOR ANY OTHER PROJECT WITHOUT THE WRITTEN AUTHORIZATION OF JACOBS.

© JACOBS 2018. ALL RIGHTS RESERVED.

MATCH LINE - SEE DWG 005-C-156

PROPERTY LINE (TYP)

EAST STORMWATER SWALE
(SEE SECTION 2, DWG 005-C-304)

6' HIGH BLACK VINYL CHAIN LINK FENCE w/
BARBED WIRE (TYP, 2.5 FT FROM EAST
PROPERTY LINE. LOCATE & PROTECT GAS)
(3213-410)

SILT FENCE (2 FT FROM FENCE) (3125-165)

NATURAL GAS PIPE MARKER POST
(100 FT INTERVALS AND CHANGES
IN DIRECTION, TYP)
(3305-960)


EROSION BLANKET OVER SWALE
SHOWN CROSS-HATCHED.
BLANKET TO EXTEND 2 FT (MIN)
ABOVE SWALE BOTTOM.

EXIST 8" NATURAL GAS MAIN
AND 10' WIDE NATURAL
GAS EASEMENT

COMPOST FIBER CHECK DAM
(100-FT SPACING, TYP)
(3125-185)

RIPRAP PROTECTION
TYPE B (12-INCH)
22' x 40' x 24" DEEP
(EXTEND TO EL 996)
(3215-170)

STAGING AREA 4 - 1 ACRES
(SEE NOTE 4 ON DWG 005-C-151)

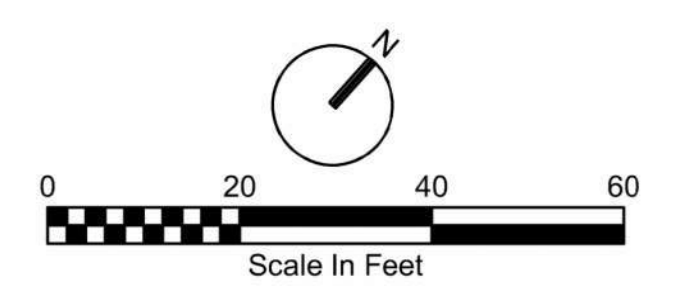

NOTES


- SEE NOTES ON SITE PLAN SHEET 1, DWG 005-C-151.
- THE STORMWATER AND PLANT DRAIN SYSTEM ARE PRELIMINARY. THE FINAL DESIGN WILL BE RELEASED IN A FUTURE PHASE. FOR PRELIMINARY PIPE PROFILES FOR STORMWATER (STM), SEE DWGS 005-C-301 TO 005-C-303. PIPE PROFILES FOR PLANT DRAIN (DR) ARE ON DWGS 005-Y-301 TO 005-Y-302.

STORMWATER STRUCTURE SCHEDULE

NOTE: SUBJECT TO CHANGE, SEE NOTE 2.

(S1-159)
CATCH BASIN ODOT SCD 2-3
TOP = 1007.33
SW INV = 992.74
E INV = 992.74

(S2-159)
HALF-HEIGHT HEADWALL
ODOT SCD HW-2.1
INV = 992.00

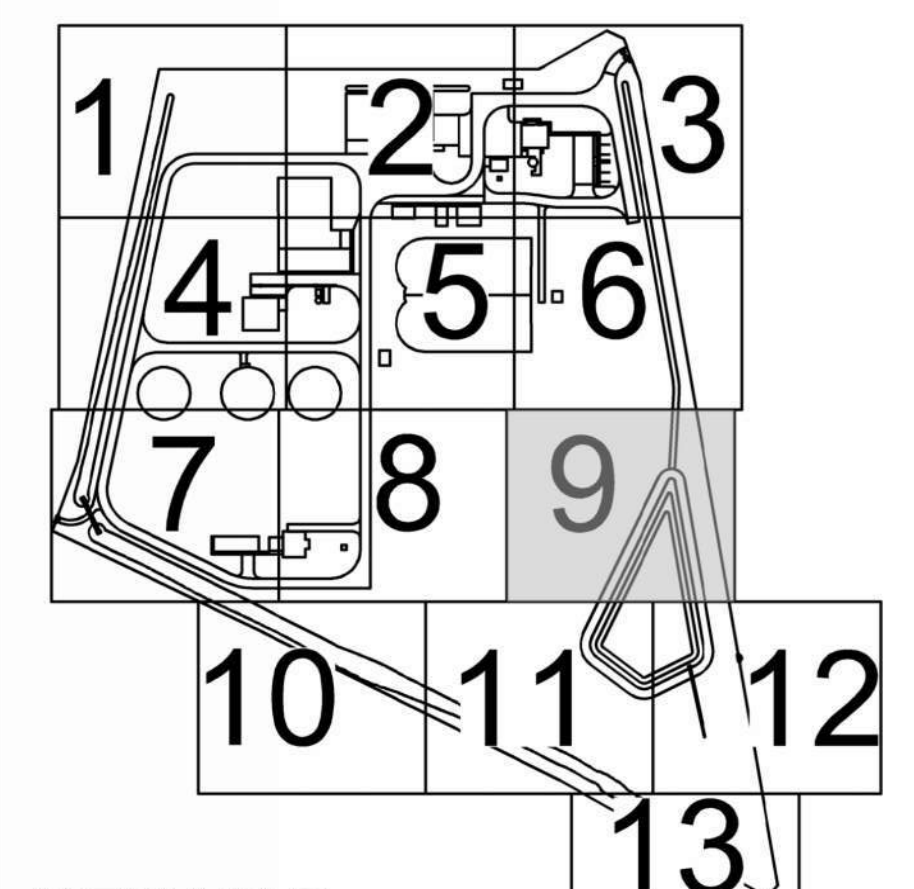

KEY MAP

MATCH LINE - SEE DWG 005-C-158

232' - 24" STM-CPE @ 0.50%
(SEE NOTE 2)

149' - 24" STM-CPE @ 0.50%
(SEE NOTE 2)

WET STORMWATER POND
(EXTENDED DETENTION BASIN)
TOP = 1003.00 / BOT = 992.00
NORMAL WATER EL = 998.00
25-YR STORM EL = 1001.36
EMERGENCY WEIR EL = 1002.00

MATCH LINE - SEE DWG 005-C-161

MATCH LINE - SEE DWG 005-C-162

Jacobs

CIVIL
EARLY SITE PACKAGE
SITE PLAN
SHEET 9

DATE	2025/08/01
PROJ	C6A24900
DWG	005-C-159

REUSE OF DOCUMENTS: THIS DOCUMENT, AND THE IDEAS AND DESIGNS INCORPORATED HEREIN, AS AN INSTRUMENT OF PROFESSIONAL SERVICE, IS THE PROPERTY OF JACOBS AND IS NOT TO BE USED, IN WHOLE OR IN PART, FOR ANY OTHER PROJECT WITHOUT THE WRITTEN AUTHORIZATION OF JACOBS.



© JACOBS 2018. ALL RIGHTS RESERVED.

T. MALONE
P. MADEJ
J. RAMOS
T. MALONE

DEER CREEK WRF
Mid-Ohio Water and Sewer District
London - OH

1" = 20'
VERIFY SCALE
BAR IS ONE INCH ON ORIGINAL DRAWING.

P.T.I. DOCUMENT

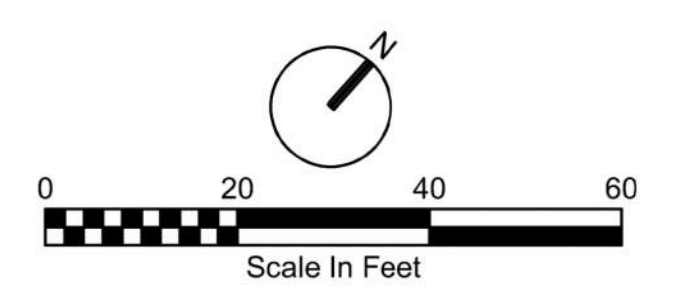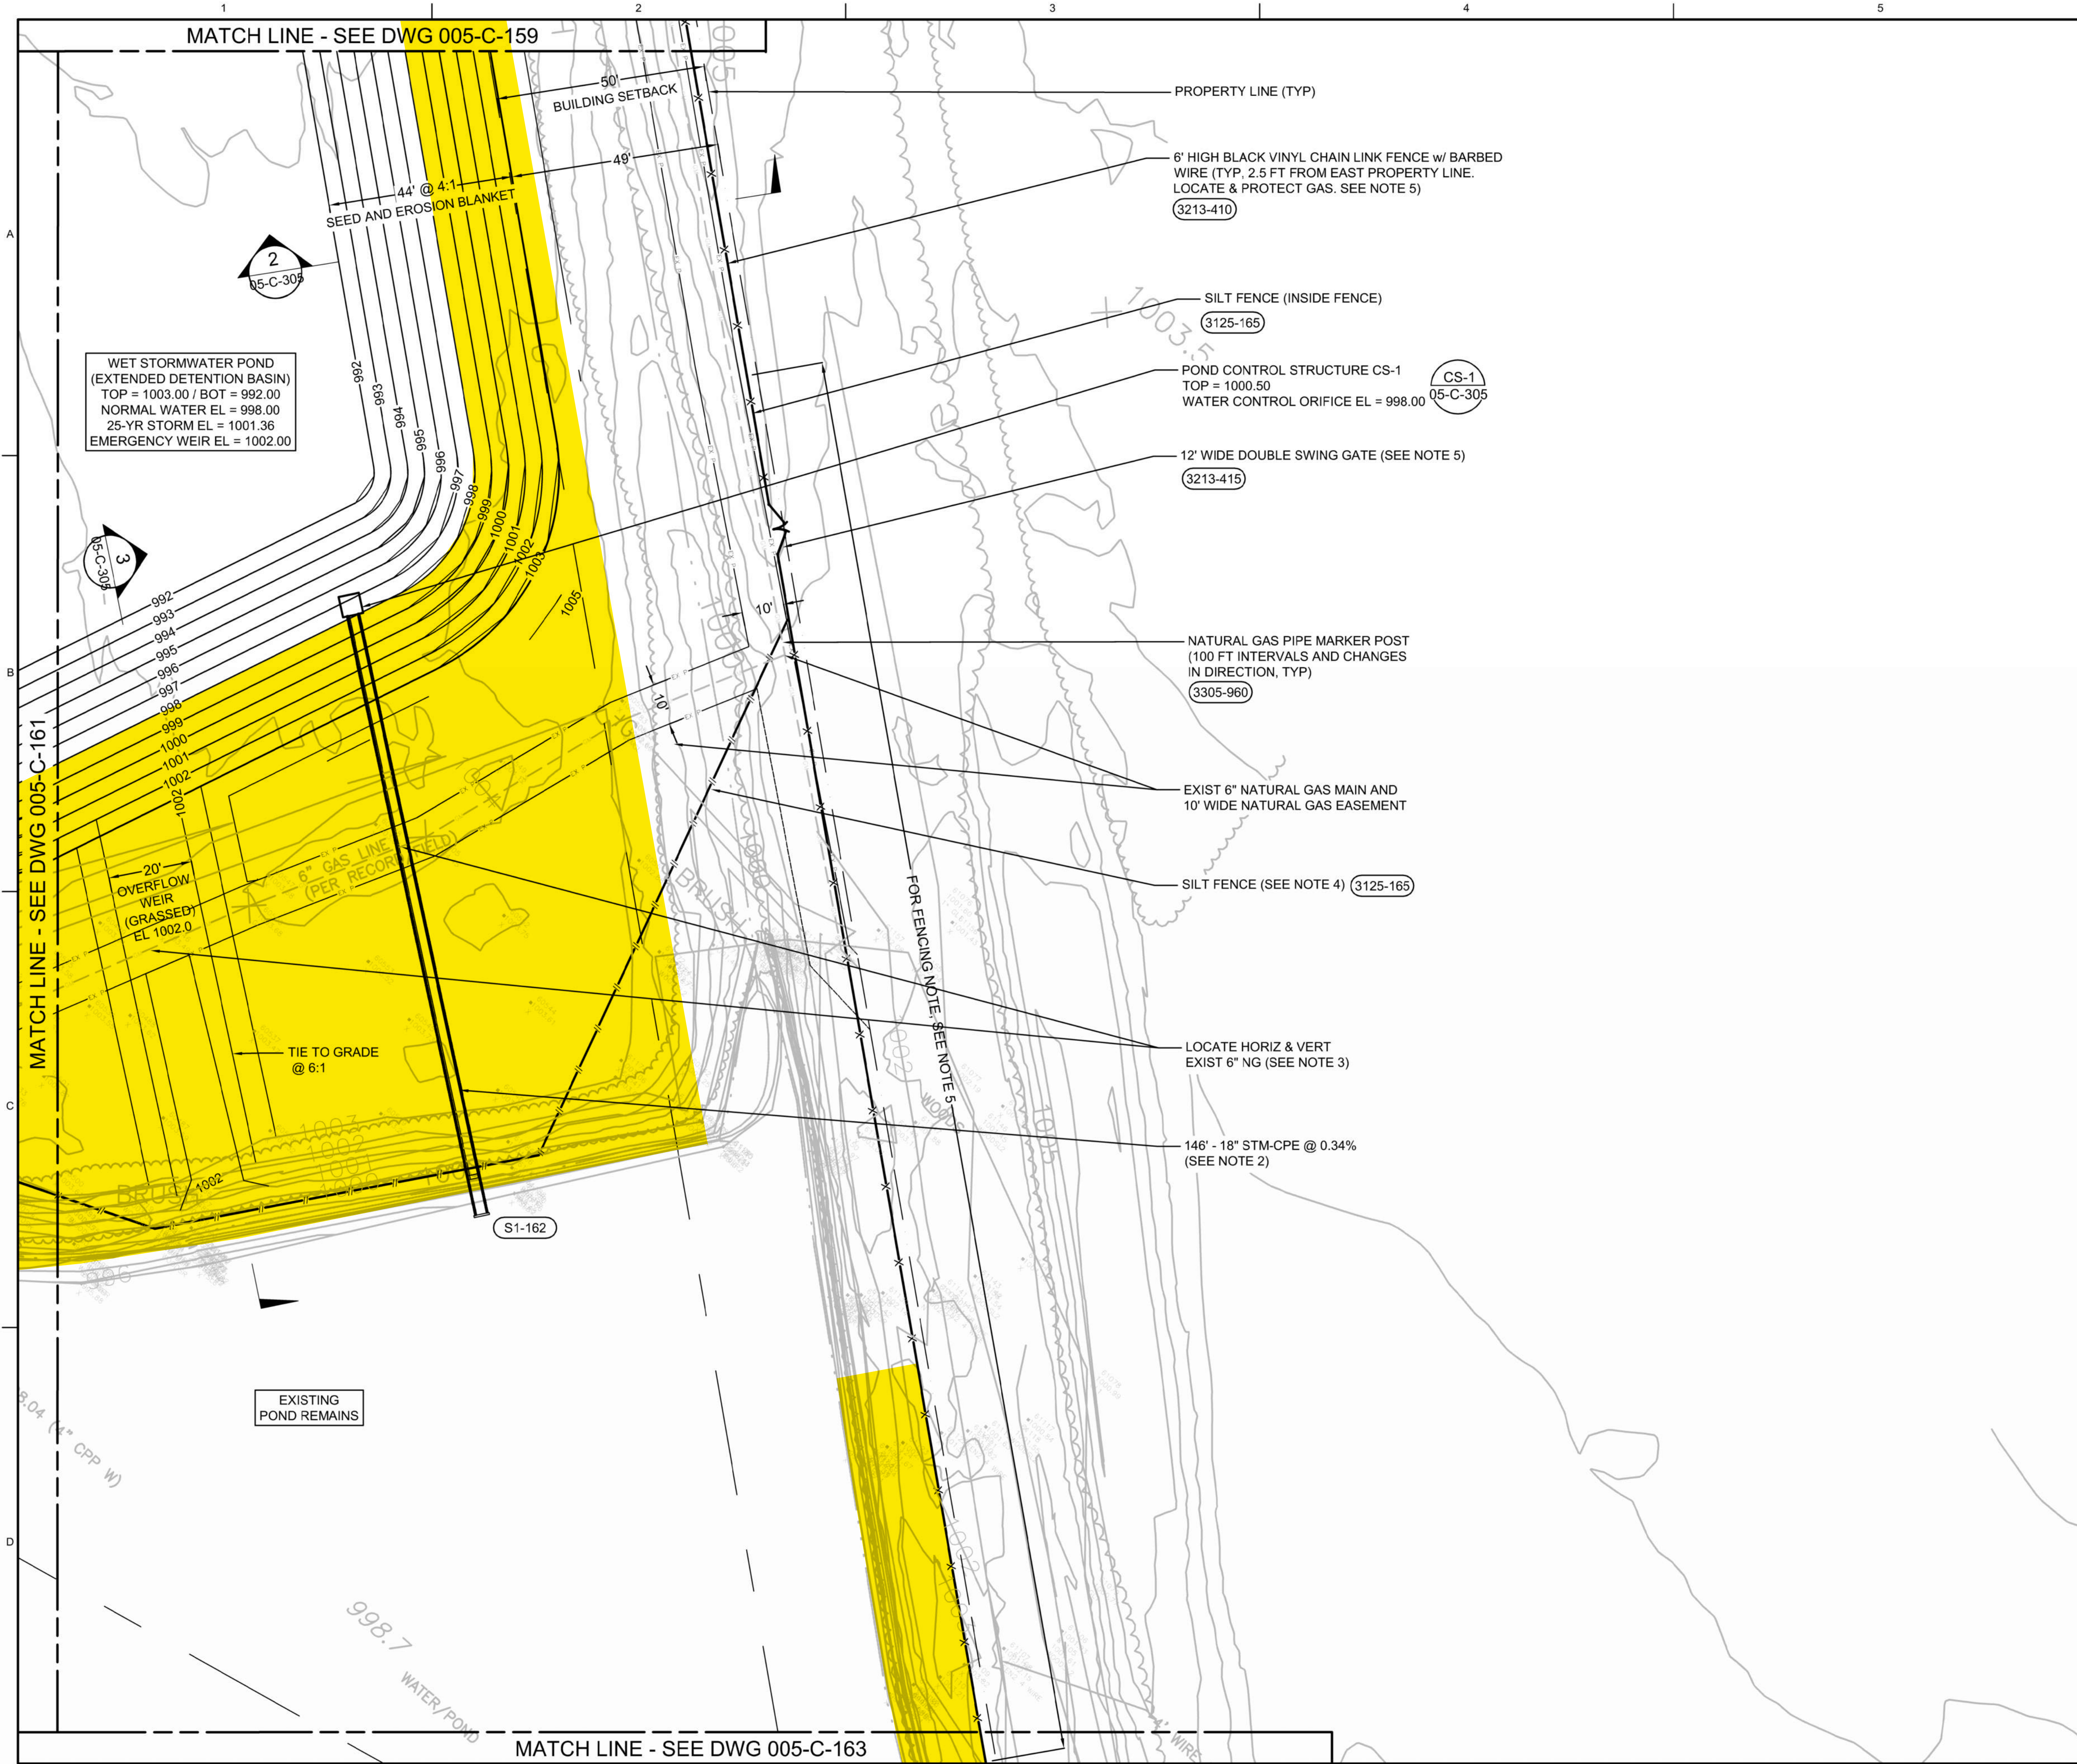


- ### NOTES
- SEE NOTES ON SITE PLAN SHEET 1, DWG 005-C-151.
 - THE STORMWATER AND PLANT DRAIN SYSTEM ARE PRELIMINARY. THE FINAL DESIGN WILL BE RELEASED IN A FUTURE PHASE. FOR PRELIMINARY PIPE PROFILES FOR STORMWATER (STM), SEE DWGS 005-C-301 TO 005-C-303. PIPE PROFILES FOR PLANT DRAIN (DR) ARE ON DWGS 005-Y-301 TO 005-Y-302.
 - CONFIRM 6" GAS MAIN LOCATION AND PERFORM SOFT DIGS TO CONFIRM TOP OF MAIN, ESPECIALLY WHERE IT CROSSES THE PROPOSED CONTROL STRUCTURE OUTFALL PIPE AND GRASSED OVERFLOW WEIR. NOTIFY ENGINEER OF COVER ISSUES. CONCRETE ENCASEMENT OR LOWERING OF THE GAS MAIN BY THE UTILITY MAY BE REQUIRED.
 - REMOVE SILT FENCE FOR STORMWATER POND OVERFLOW AND OUTFALL PIPE CONSTRUCTION. REINSTALL AFTER THESE ELEMENTS ARE INSTALLED.
 - FUTURE WATER AND SANITARY FORCEMAINS WILL BE ROUTED THROUGH THE EAST PROPERTY CORNER. TEMPORARY FENCING AND GATE MAY BE INSTALLED DURING THIS PHASE AND REPLACED WITH PERMANENT FENCING AFTER MAIN INSTALLATION.

STORMWATER STRUCTURE SCHEDULE

NOTE: SUBJECT TO CHANGE, SEE NOTE 2.

S1-162

HALF-HEIGHT HEADWALL
 ODOT SCD HW-2.1
 INV = 996.00

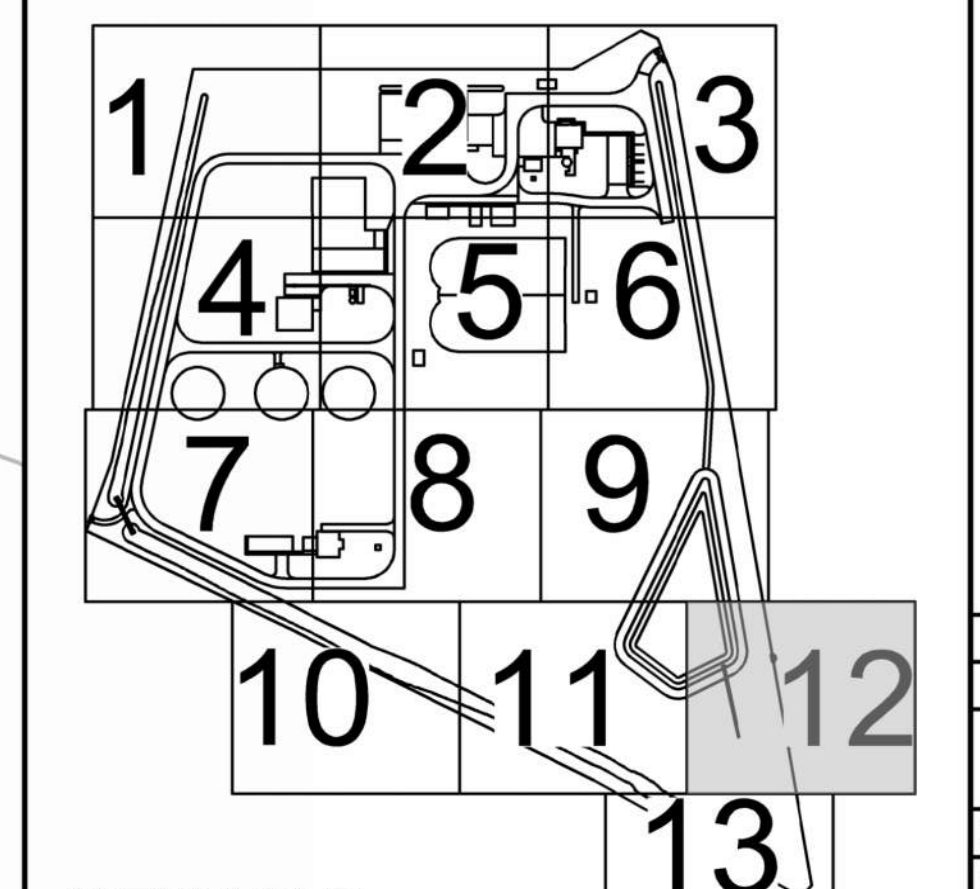

KEY MAP

NO.	DATE	DR	CHK	APVD	BY	APRV
		T. MALONE	P. MADEJ	J. RAMOS		T. MALONE

DEER CREEK WRF
 Mid-Ohio Water and Sewer District
 London - OH

Jacobs





CIVIL
**EARLY SITE PACKAGE
 SITE PLAN
 SHEET 12**

1" = 20'
 VERIFY SCALE
 BAR IS ONE INCH ON ORIGINAL DRAWING.

DATE 2025/08/01
 PROJ C6A24900
 DWG 005-C-162

PTI DOCUMENT

REUSE OF DOCUMENTS: THIS DOCUMENT AND THE IDEAS AND DESIGNS INCORPORATED HEREIN, AS AN INSTRUMENT OF PROFESSIONAL SERVICE, IS THE PROPERTY OF JACOBS AND IS NOT TO BE USED, IN WHOLE OR IN PART, FOR ANY OTHER PROJECT WITHOUT THE WRITTEN AUTHORIZATION OF JACOBS. © JACOBS 2018. ALL RIGHTS RESERVED.

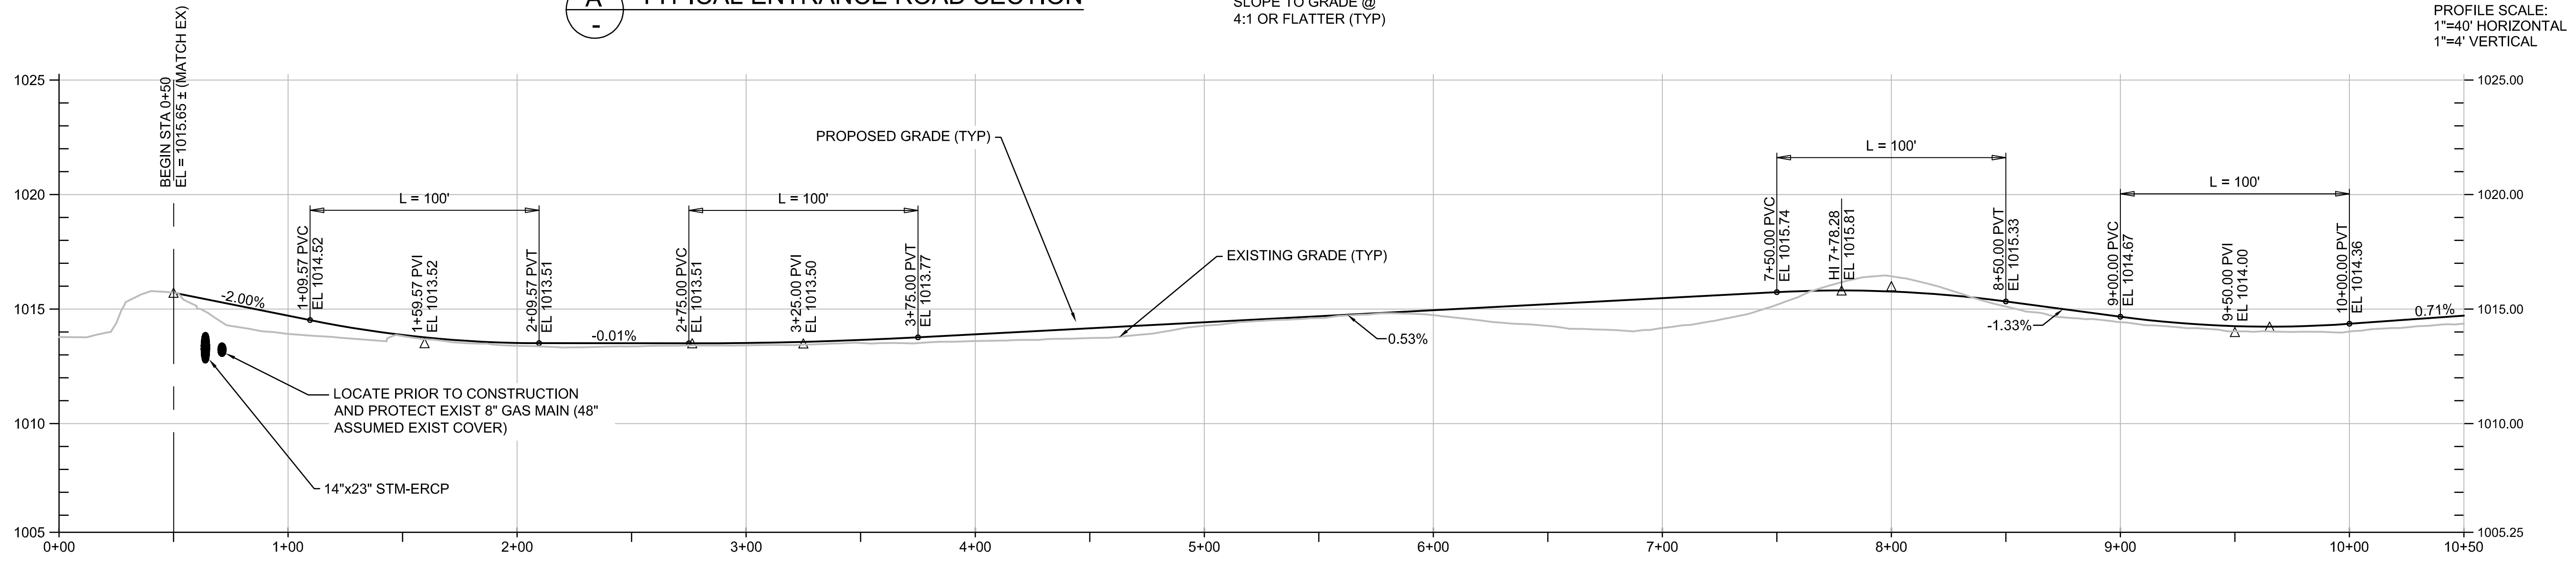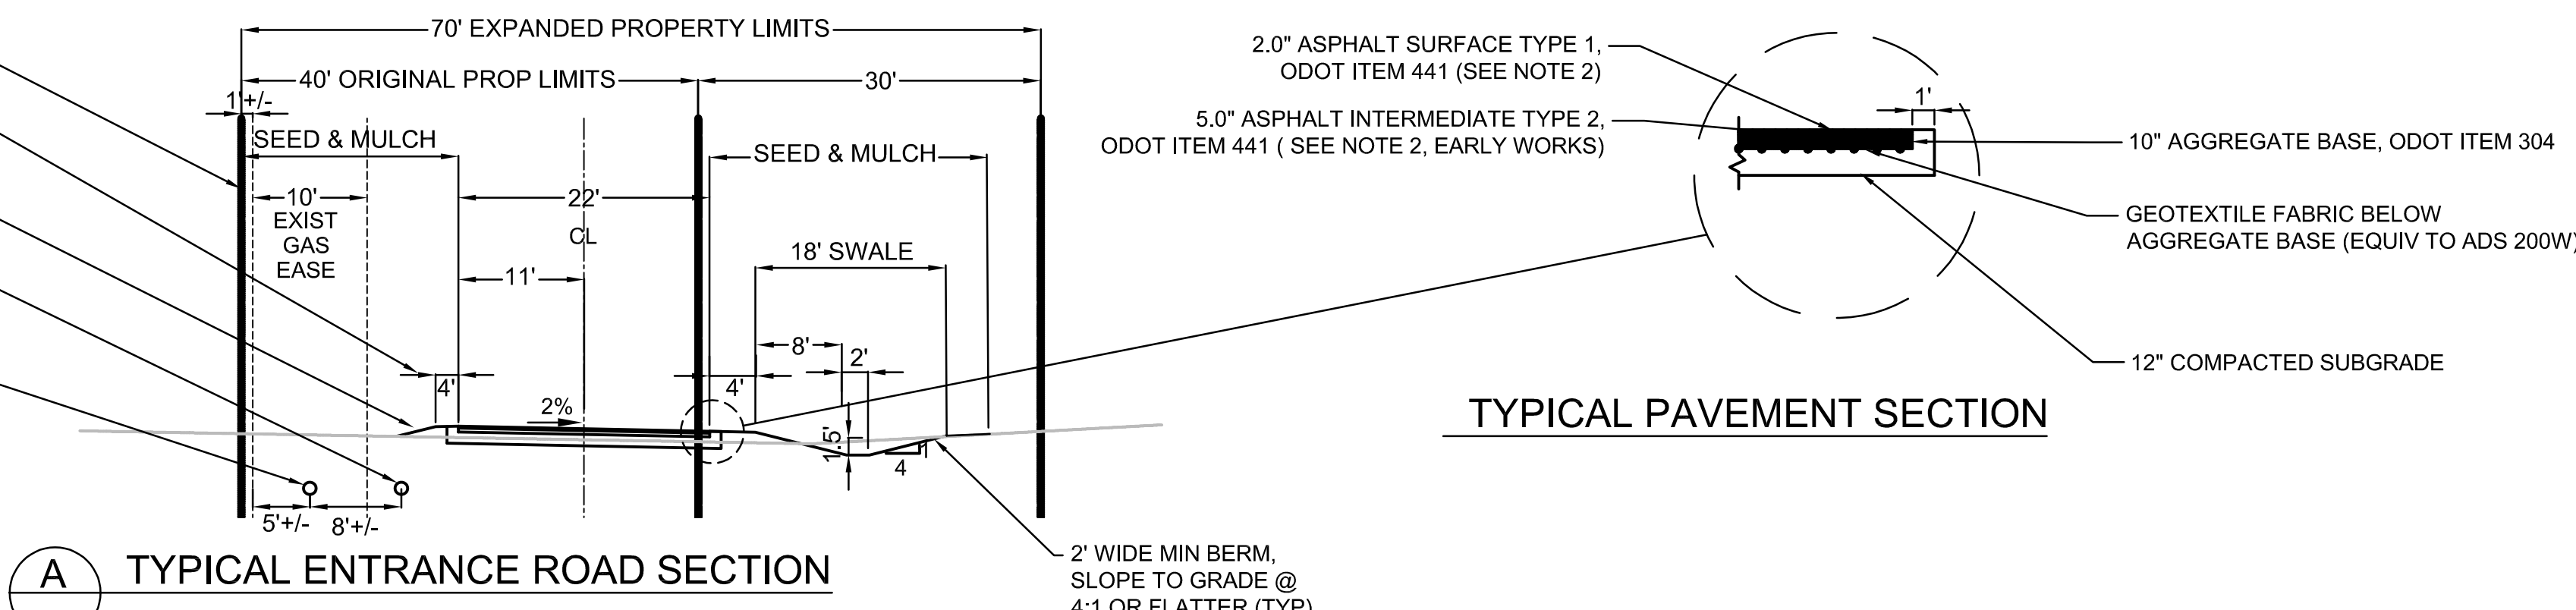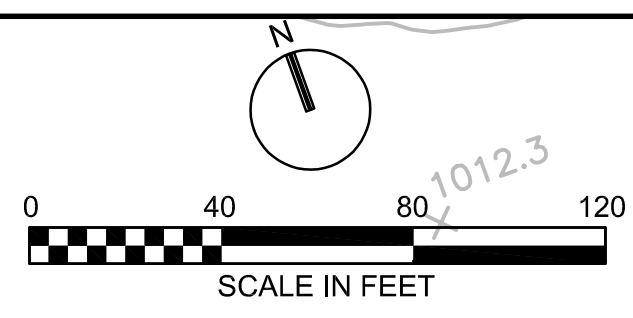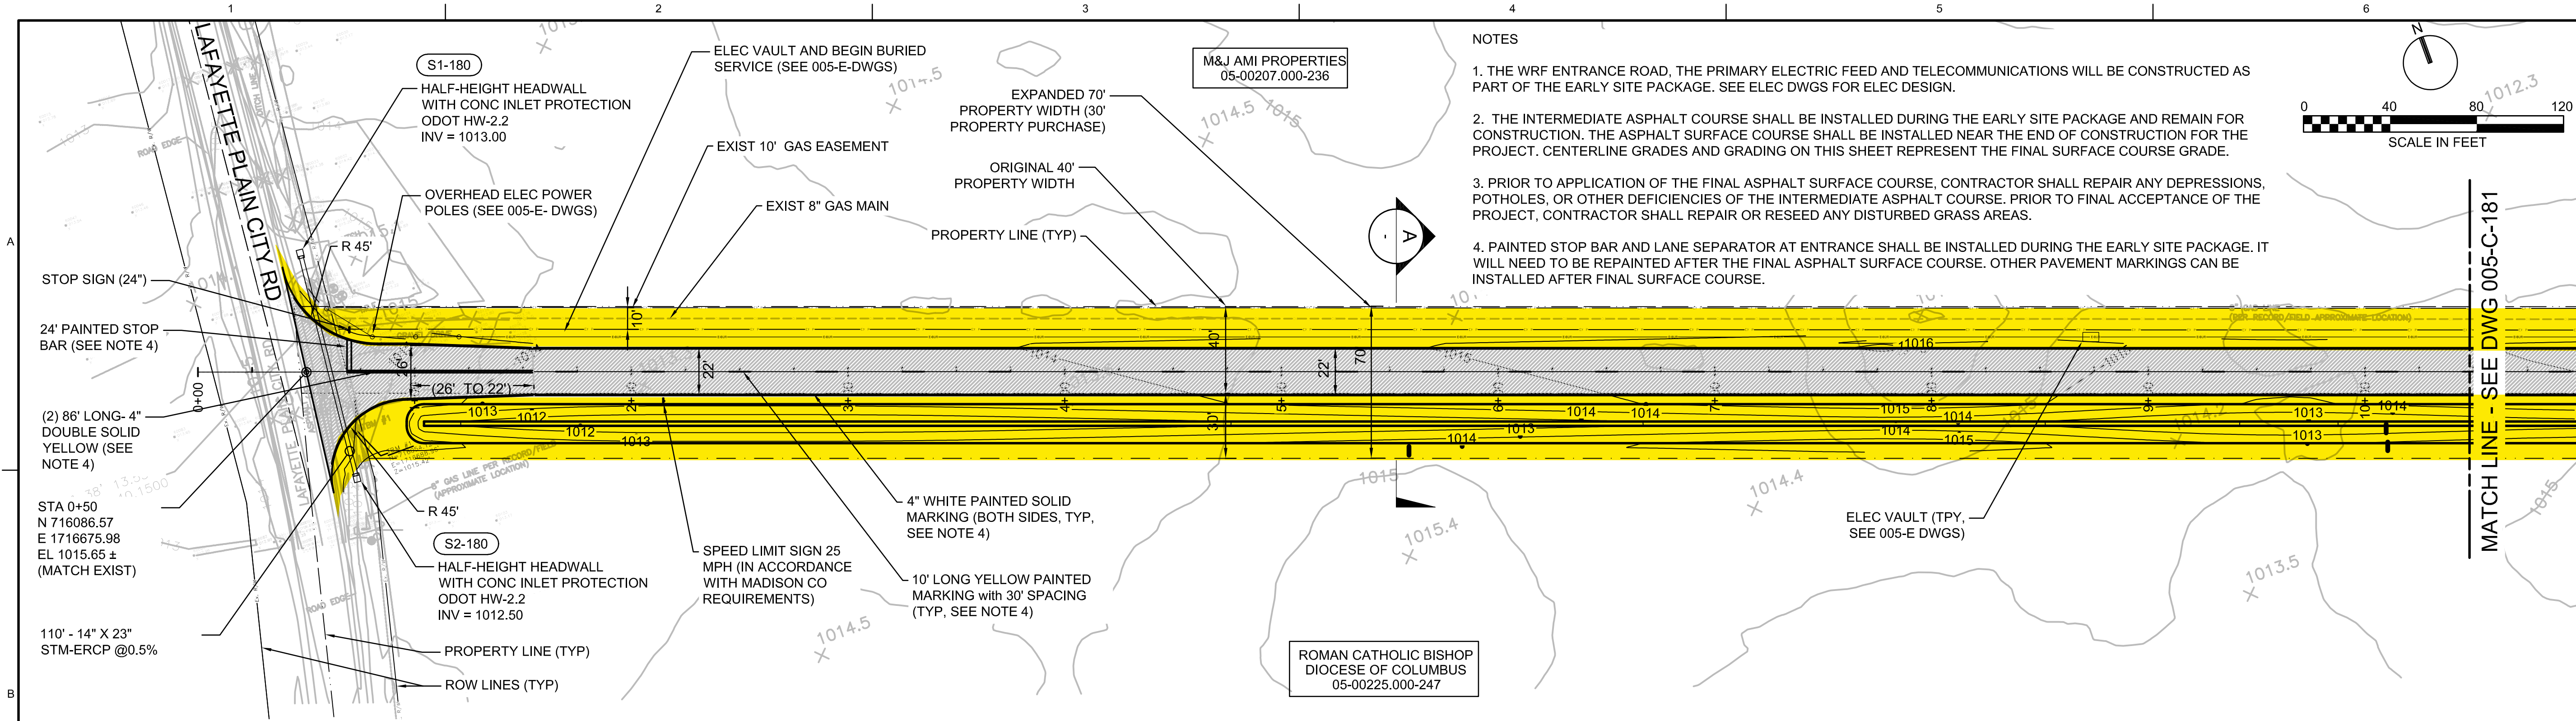


NO.	DATE	DR	CHK	APVD	BY
		T. MALONE	P. MADEJ	J. RAMOS	T. MALONE

DEER CREEK WRF
 Mid-Ohio Water and Sewer District
 London - OH



Jacobs
 CIVIL
 ENTRANCE ROAD
 PLAN AND PROFILE
 SHEET 1

DATE	2025/08/01
PROJ	C6A24900
DWG	005-C-180

PTI DOCUMENT
 REUSE OF DOCUMENTS: THIS DOCUMENT, AND THE IDEAS AND DESIGNS INCORPORATED HEREIN, AS AN INSTRUMENT OF PROFESSIONAL SERVICE, IS THE PROPERTY OF JACOBS AND IS NOT TO BE USED, IN WHOLE OR IN PART, FOR ANY OTHER PROJECT WITHOUT THE WRITTEN AUTHORIZATION OF JACOBS.
 © JACOBS 2018. ALL RIGHTS RESERVED.

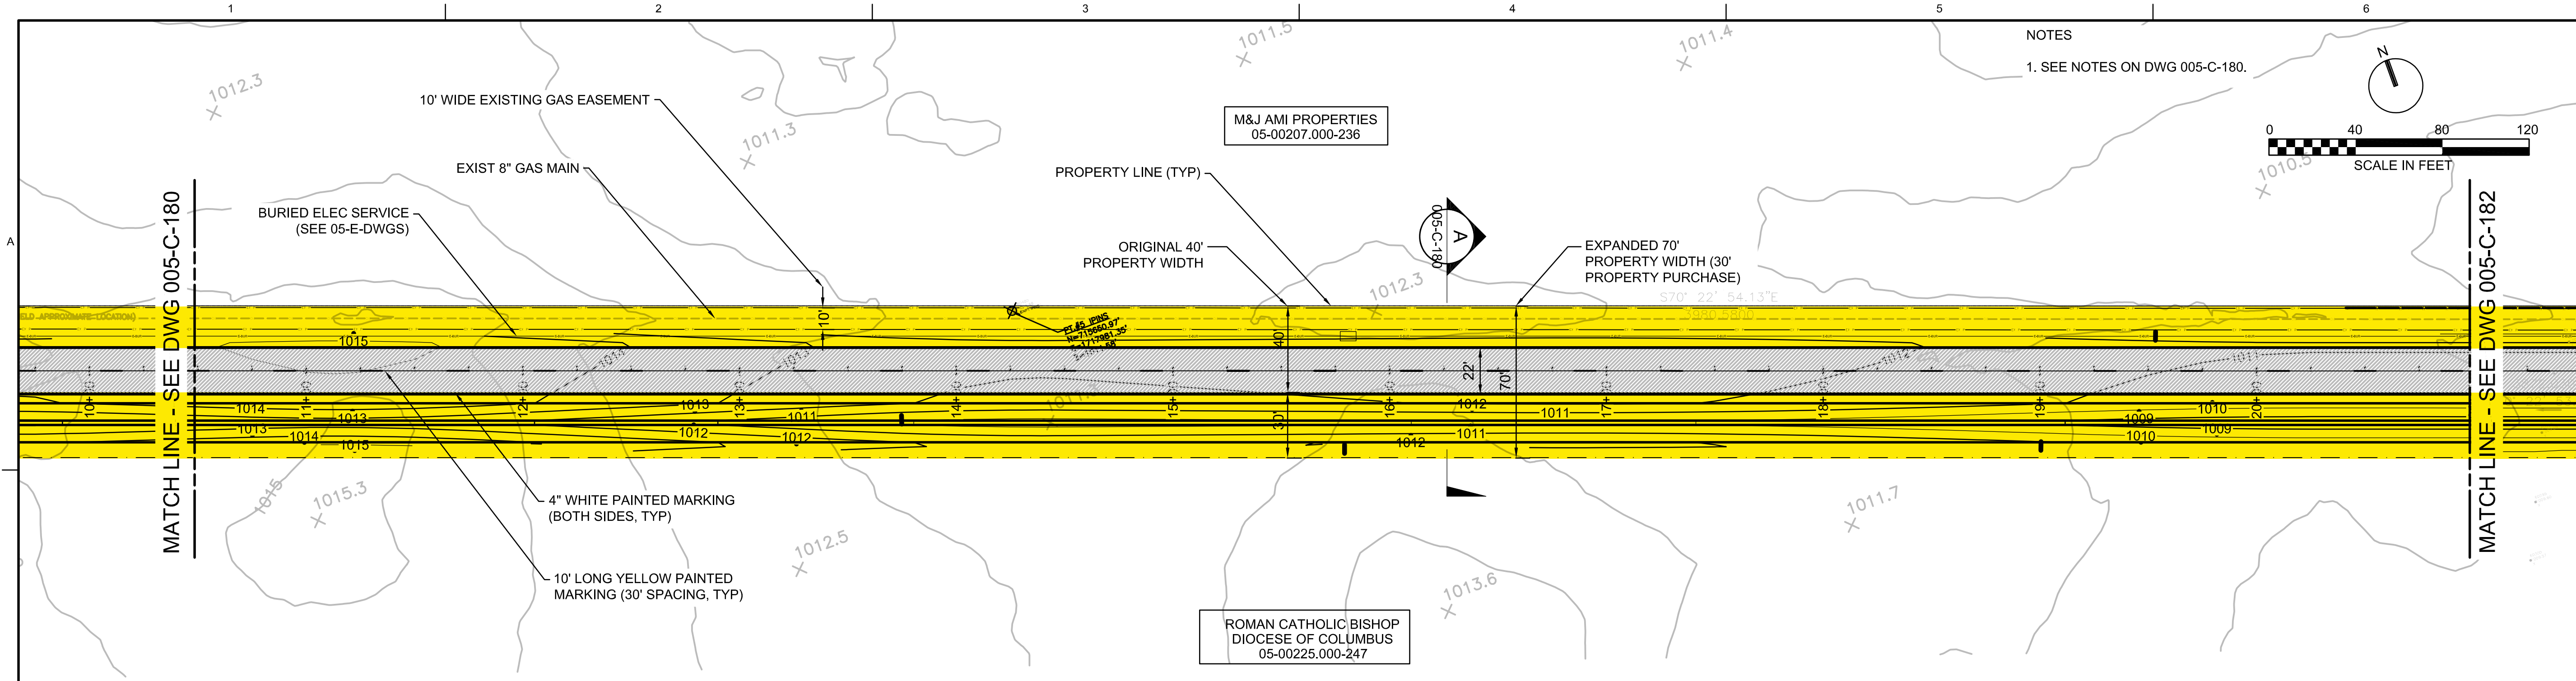

NOTES
1. SEE NOTES ON DWG 005-C-180.

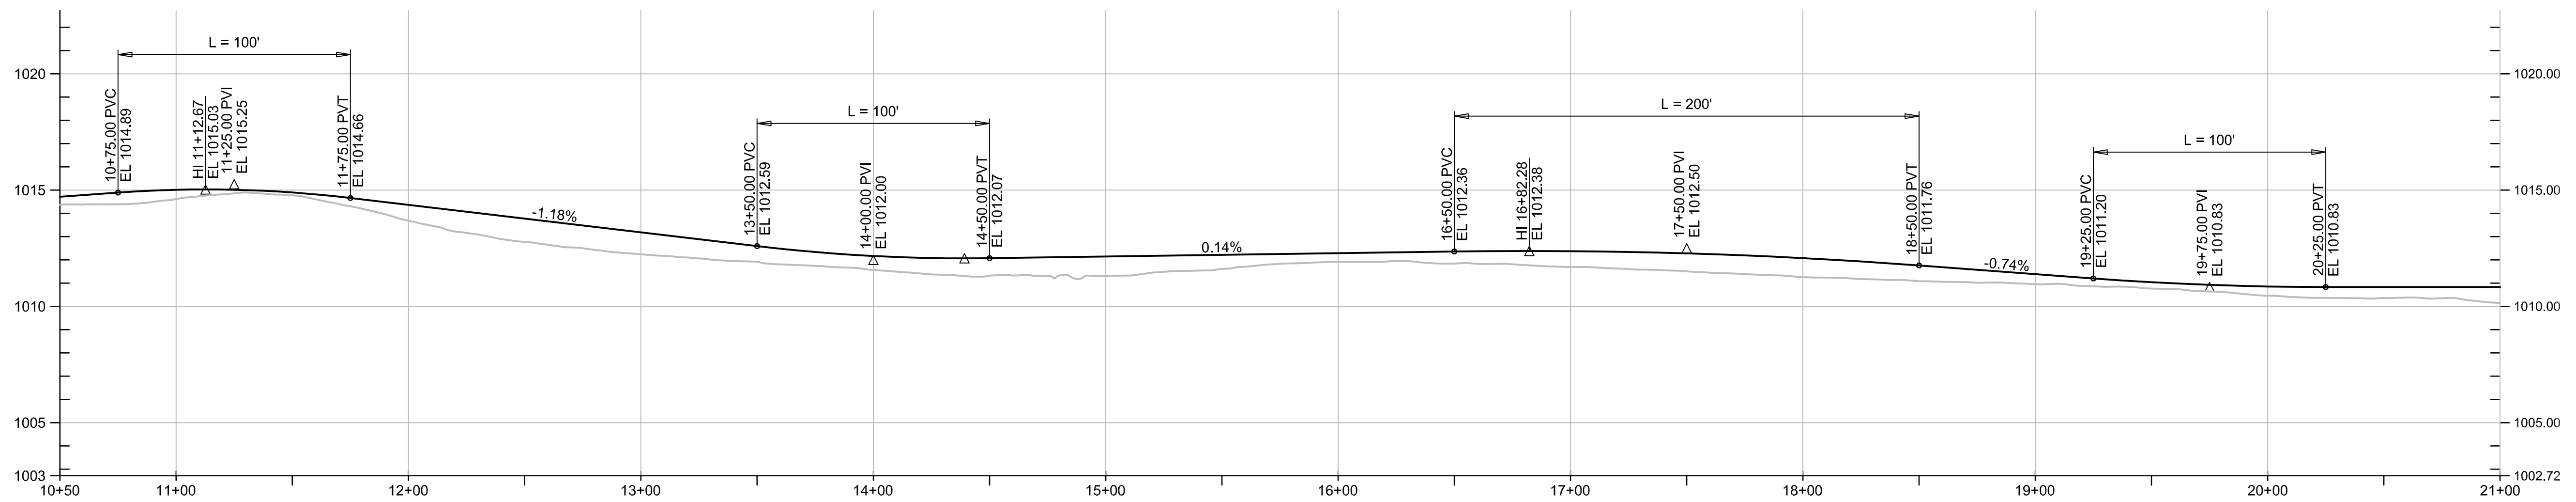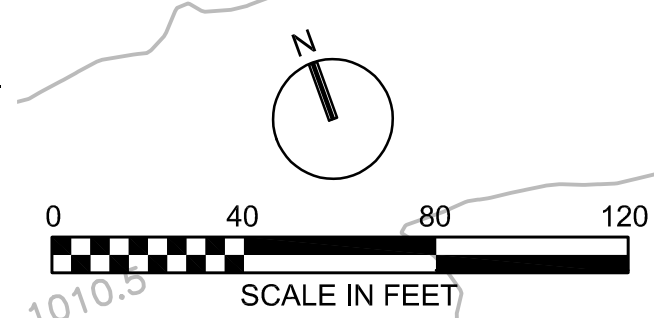


PROFILE SCALE:
1"=40' HORIZONTAL
1"=4' VERTICAL



		DEER CREEK WRF		T. MALONE	
		Mid-Ohio Water and Sewer District London - OH		J. RAMOS	
CIVIL		DR		APVD	
ENTRANCE ROAD		NO.		BY	
PLAN AND PROFILE		DATE		APRV	
SHEET 2		DSGN		CHK	
1" = 40'		DSGN		T. MALONE	
VERIFY SCALE		NO.		APRV	
BAR IS ONE INCH ON ORIGINAL DRAWING.		DATE		APRV	
DATE 2025/08/01		NO.		APRV	
PROJ C6A24900		DATE		APRV	
DWG 005-C-181		NO.		APRV	

PTI DOCUMENT

REUSE OF DOCUMENTS: THIS DOCUMENT, AND THE IDEAS AND DESIGNS INCORPORATED HEREIN, AS AN INSTRUMENT OF PROFESSIONAL SERVICE, IS THE PROPERTY OF JACOBS AND IS NOT TO BE USED, IN WHOLE OR IN PART, FOR ANY OTHER PROJECT WITHOUT THE WRITTEN AUTHORIZATION OF JACOBS. © JACOBS 2018. ALL RIGHTS RESERVED.

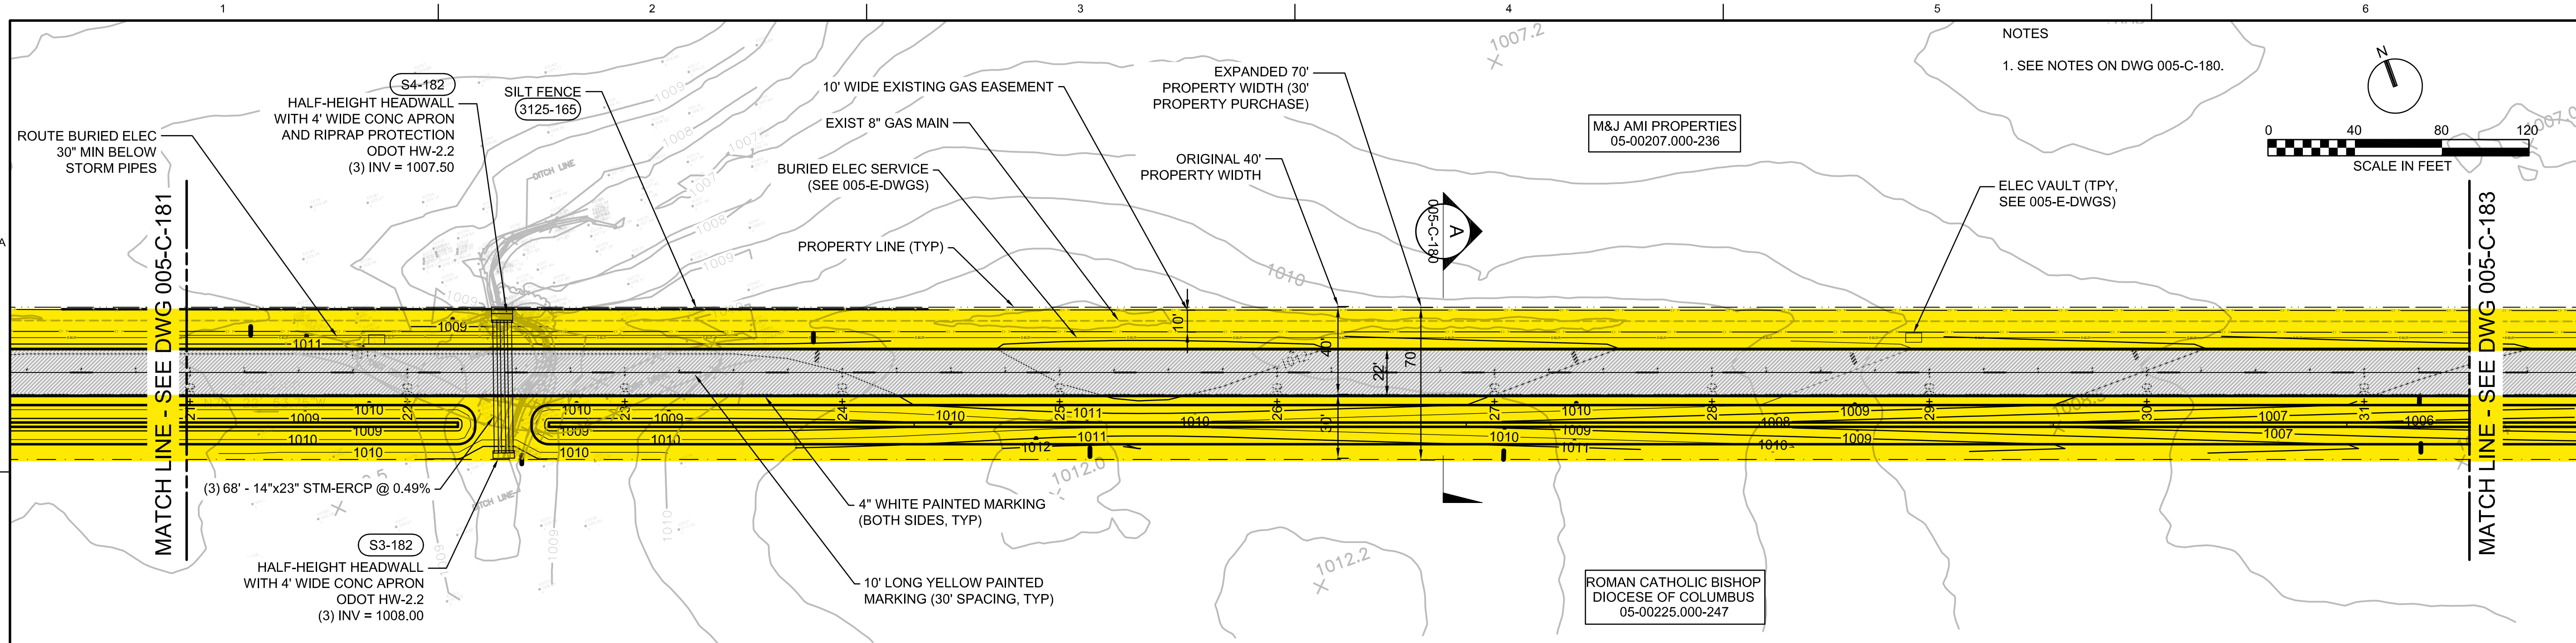

NOTES
1. SEE NOTES ON DWG 005-C-180.

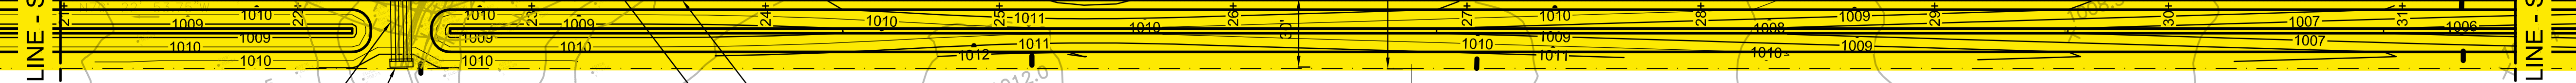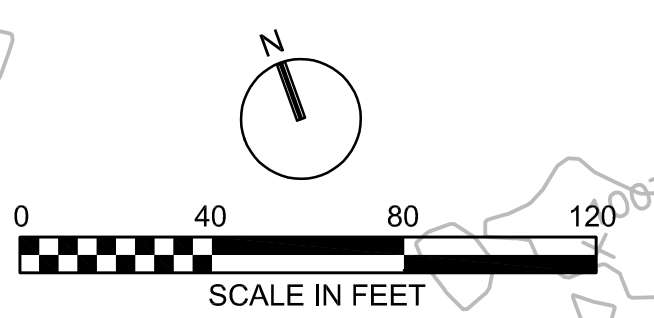

PROFILE SCALE:
1"=40' HORIZONTAL
1"=4' VERTICAL

Jacobs

CIVIL
ENTRANCE ROAD
PLAN AND PROFILE
SHEET 3

DEER CREEK WRF
Mid-Ohio Water and Sewer District
London - OH

1" = 40'	
VERIFY SCALE	
BAR IS ONE INCH ON ORIGINAL DRAWING.	
DATE	2025/08/01
PROJ	C6A24900
DWG	005-C-182

NO.	DATE	DR	CHK	APVD	BY
		T. MALONE	P. MADEJ	J. RAMOS	T. MALONE

PTI DOCUMENT
REUSE OF DOCUMENTS: THIS DOCUMENT, AND THE IDEAS AND DESIGNS INCORPORATED HEREIN, AS AN INSTRUMENT OF PROFESSIONAL SERVICE, IS THE PROPERTY OF JACOBS AND IS NOT TO BE USED, IN WHOLE OR IN PART, FOR ANY OTHER PROJECT WITHOUT THE WRITTEN AUTHORIZATION OF JACOBS. © JACOBS 2018. ALL RIGHTS RESERVED.

